


Gidw.

PROJECT Phase II SHEET OF
SUBJECT DATE 8-4-18
JOB NO. 4647
BY Atlas

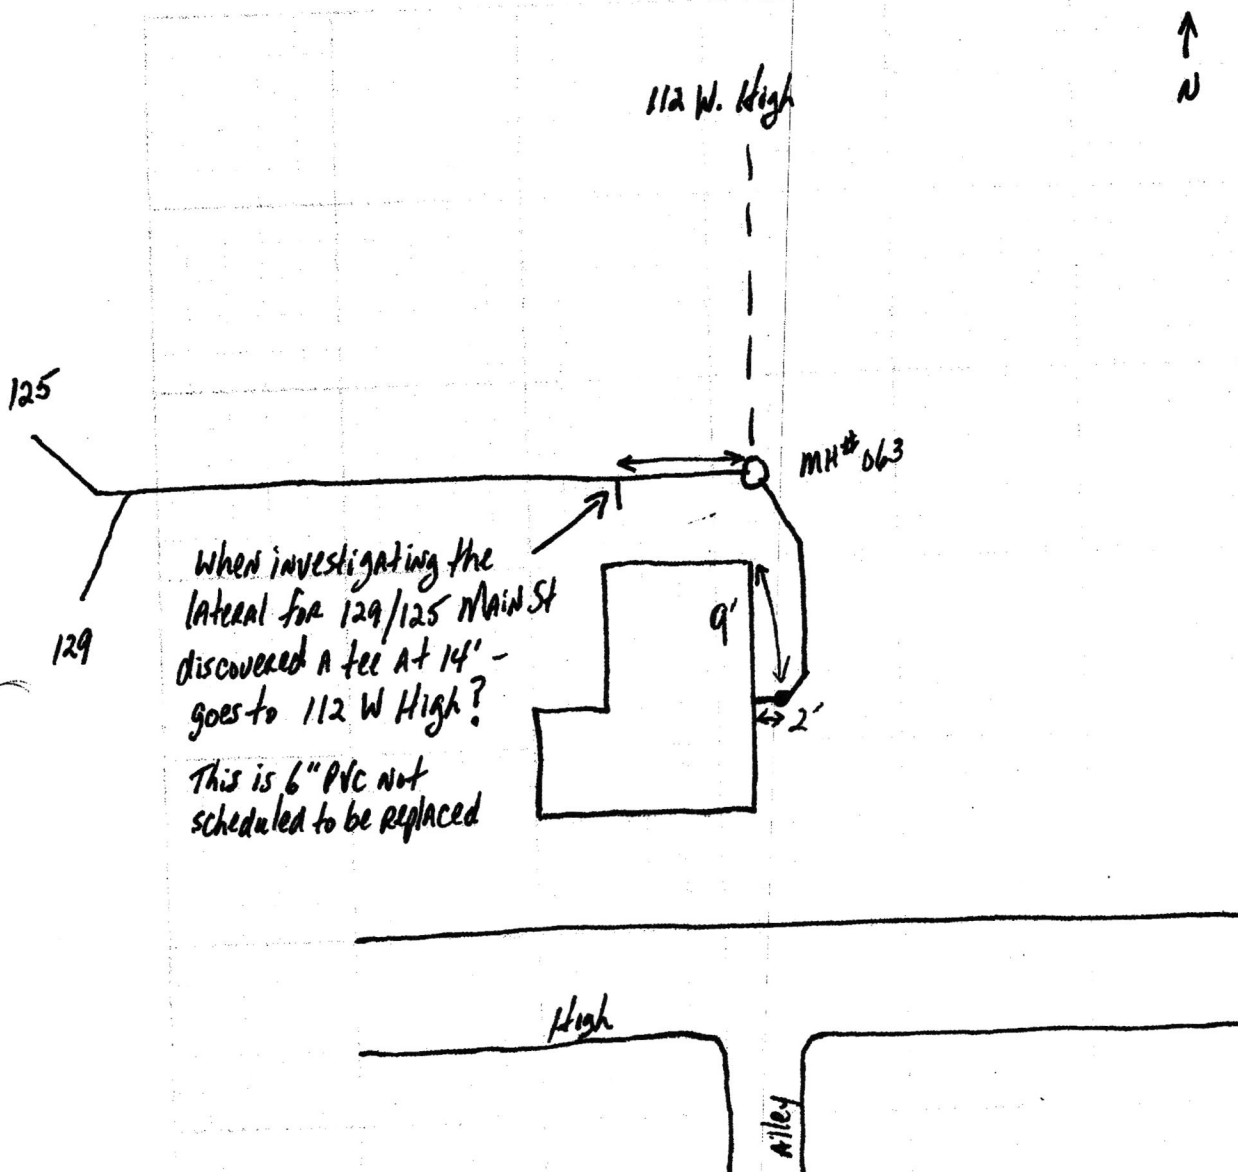

...

one phase II

8/15-18




Gidw.

PROJECT Phase II SHEET _____ OF _____


SUBJECT _____ DATE 8-4-18

JOB NO. 4447

BY Atlas

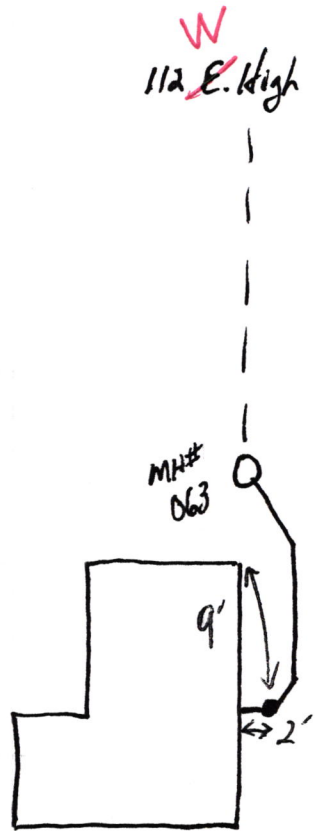

↑
N

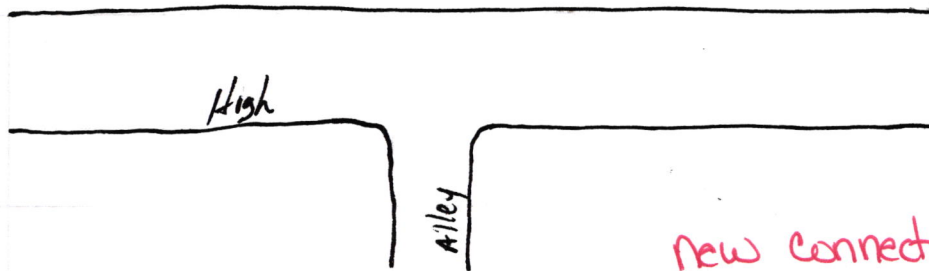

New Connection
Per Tim McCurdy