


Side.

PROJECT Phase II SHEET _____ OF _____

SUBJECT _____ DATE 7-16-18

JOB NO. 4447

BY Atlas

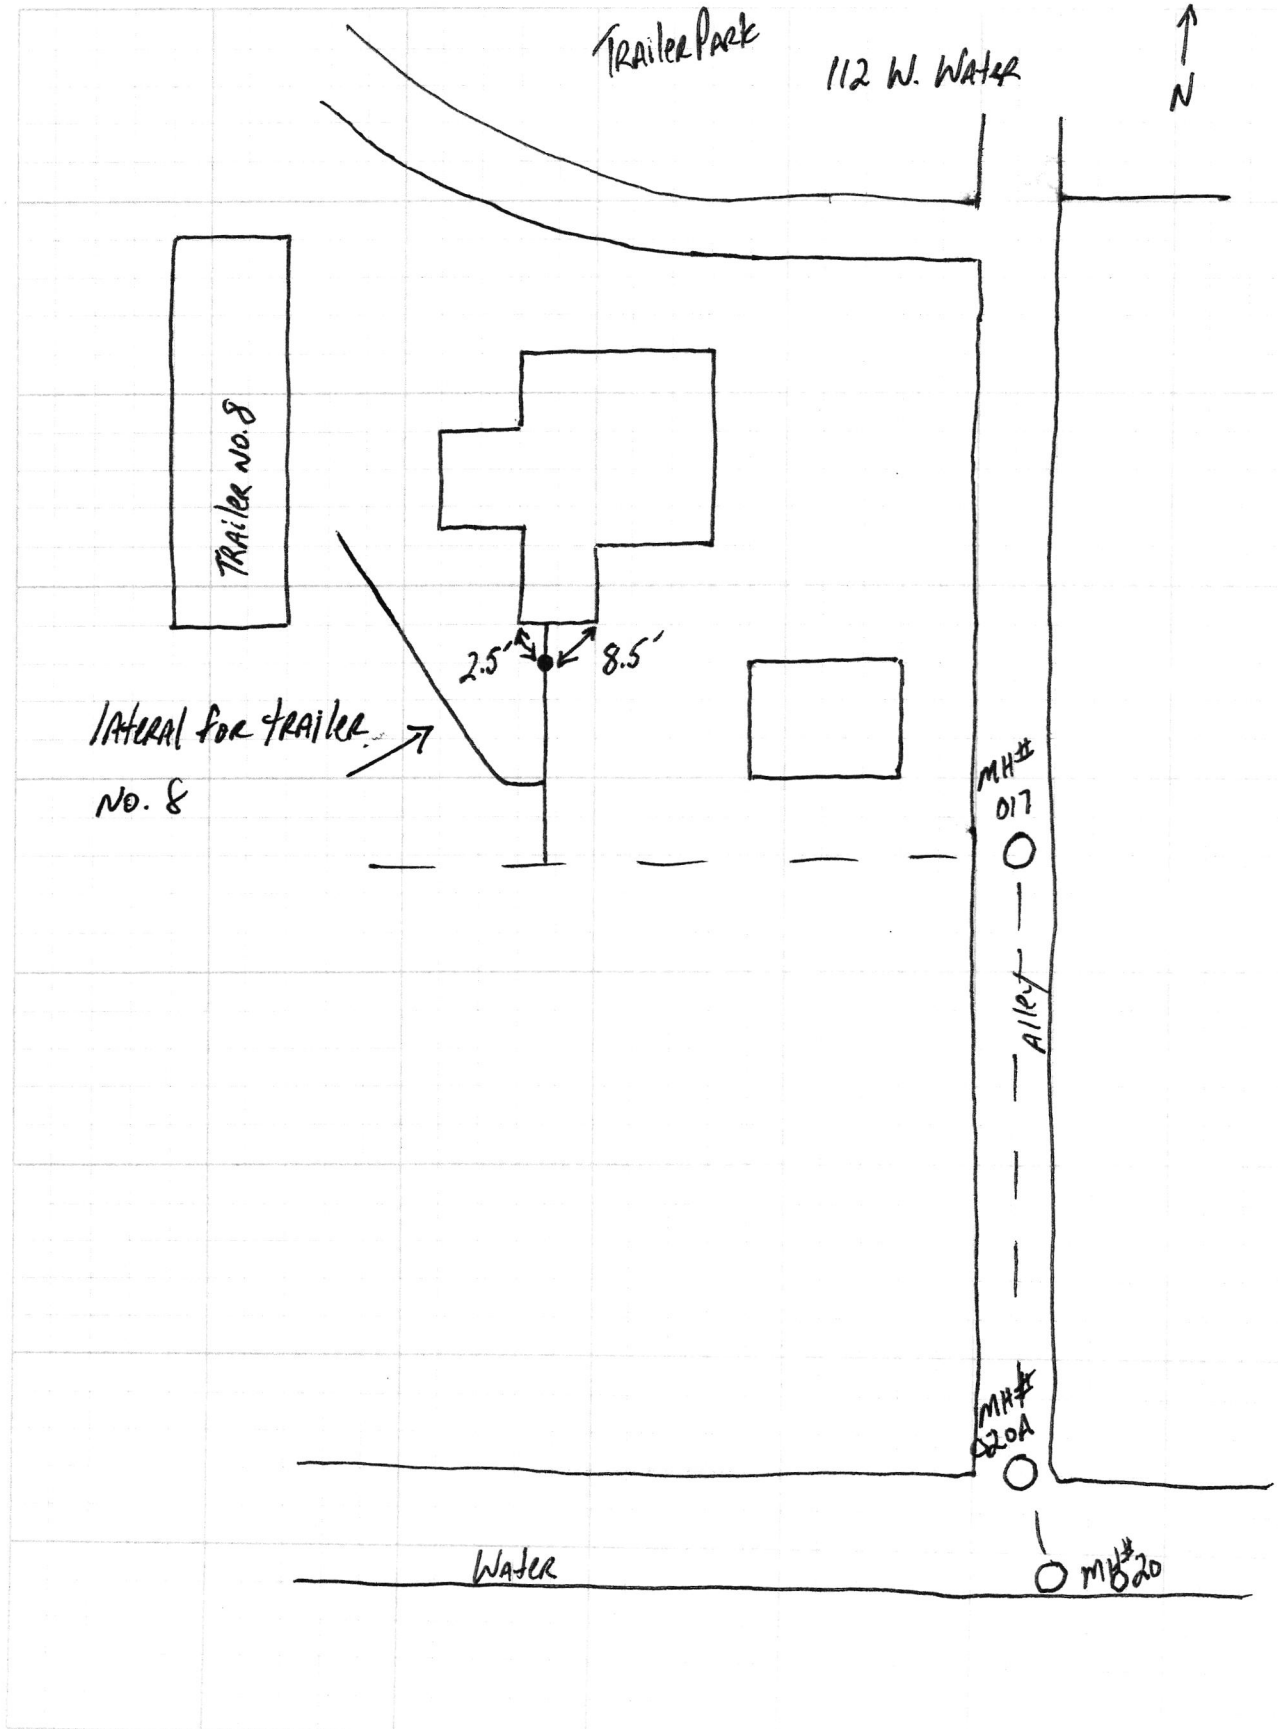

11a w water

SIF Phase II

7.18.18

