



FALL CREEK REGIONAL WASTE DISTRICT

Box 44, Pendleton, Indiana 46064

Partial insp needed

3-0026772.00

Nº 000058

APPLICATION FOR SEWER PERMIT

Permit No. _____ Date 8-1-85
Permit Void 90 days from Date of Issuance
Owner Name Mary Webb
Property Address RL Box 80, Anderson, 46011
Lot # _____ Property Box 112 W. Water
Town PENDLETON, IN Zip Code 46064
Phone _____ Water Meter 5/8
\$ 1,050.00 Tap on Fee Paid 7 trailers
\$ 175.00 Inspection fee paid

Application is hereby made for connection to the Fall Creek Regional Waste District Sewer System for the above listed property - Permit Type: Residential ☒, Commercial _____, Industrial _____, or Governmental/Institutional _____. User Information _____.

All workmanship and materials shall conform to the standards of the District Ordinance as described in Ordinance 84-2 and 84-3 as amended. Acceptance and approval must be made by the District inspector or his duly authorized representative before backfilling and final connection is made to the main sewer lines. Any violation of applicable regulations will cause all lines and appurtenances in violation to be removed and replaced at the owners expense.

The Fall Creek Regional Waste District is responsible for the inspection, approval of materials, and installation techniques only. All costs for materials and installation and any liabilities resulting from same is the sole responsibility of the property owner.

I have read and fully understand the above provisions and agree to comply by said provisions.

Mary Webb
APPLICANT(S) SIGNATURE

INSPECTOR Davis

Date inspected 11/23/85 Approved ☒ Rejected _____
Reason for rejection PARTIAL INSP. OF TRAILERS #1-2 12/6 INSP. OF #3-4

FINAL
Date reinspected 4/7/86 #5-6-7 Approved ☒ Rejected _____


Notes:
Size Pipe 6 "
Type Pipe F.V.C.
Basement Yes _____ No ☒
Sump Pump Yes _____ No ☒
Downspout to Ground Yes _____ No ☒
Septic Tank Pumped & filled Yes _____ No _____
Contractor EARL DAVIS
Special Conditions _____



57

112 WEST WATER ST. MOBIL HOME PARK (MHP)

WEST WATER ST

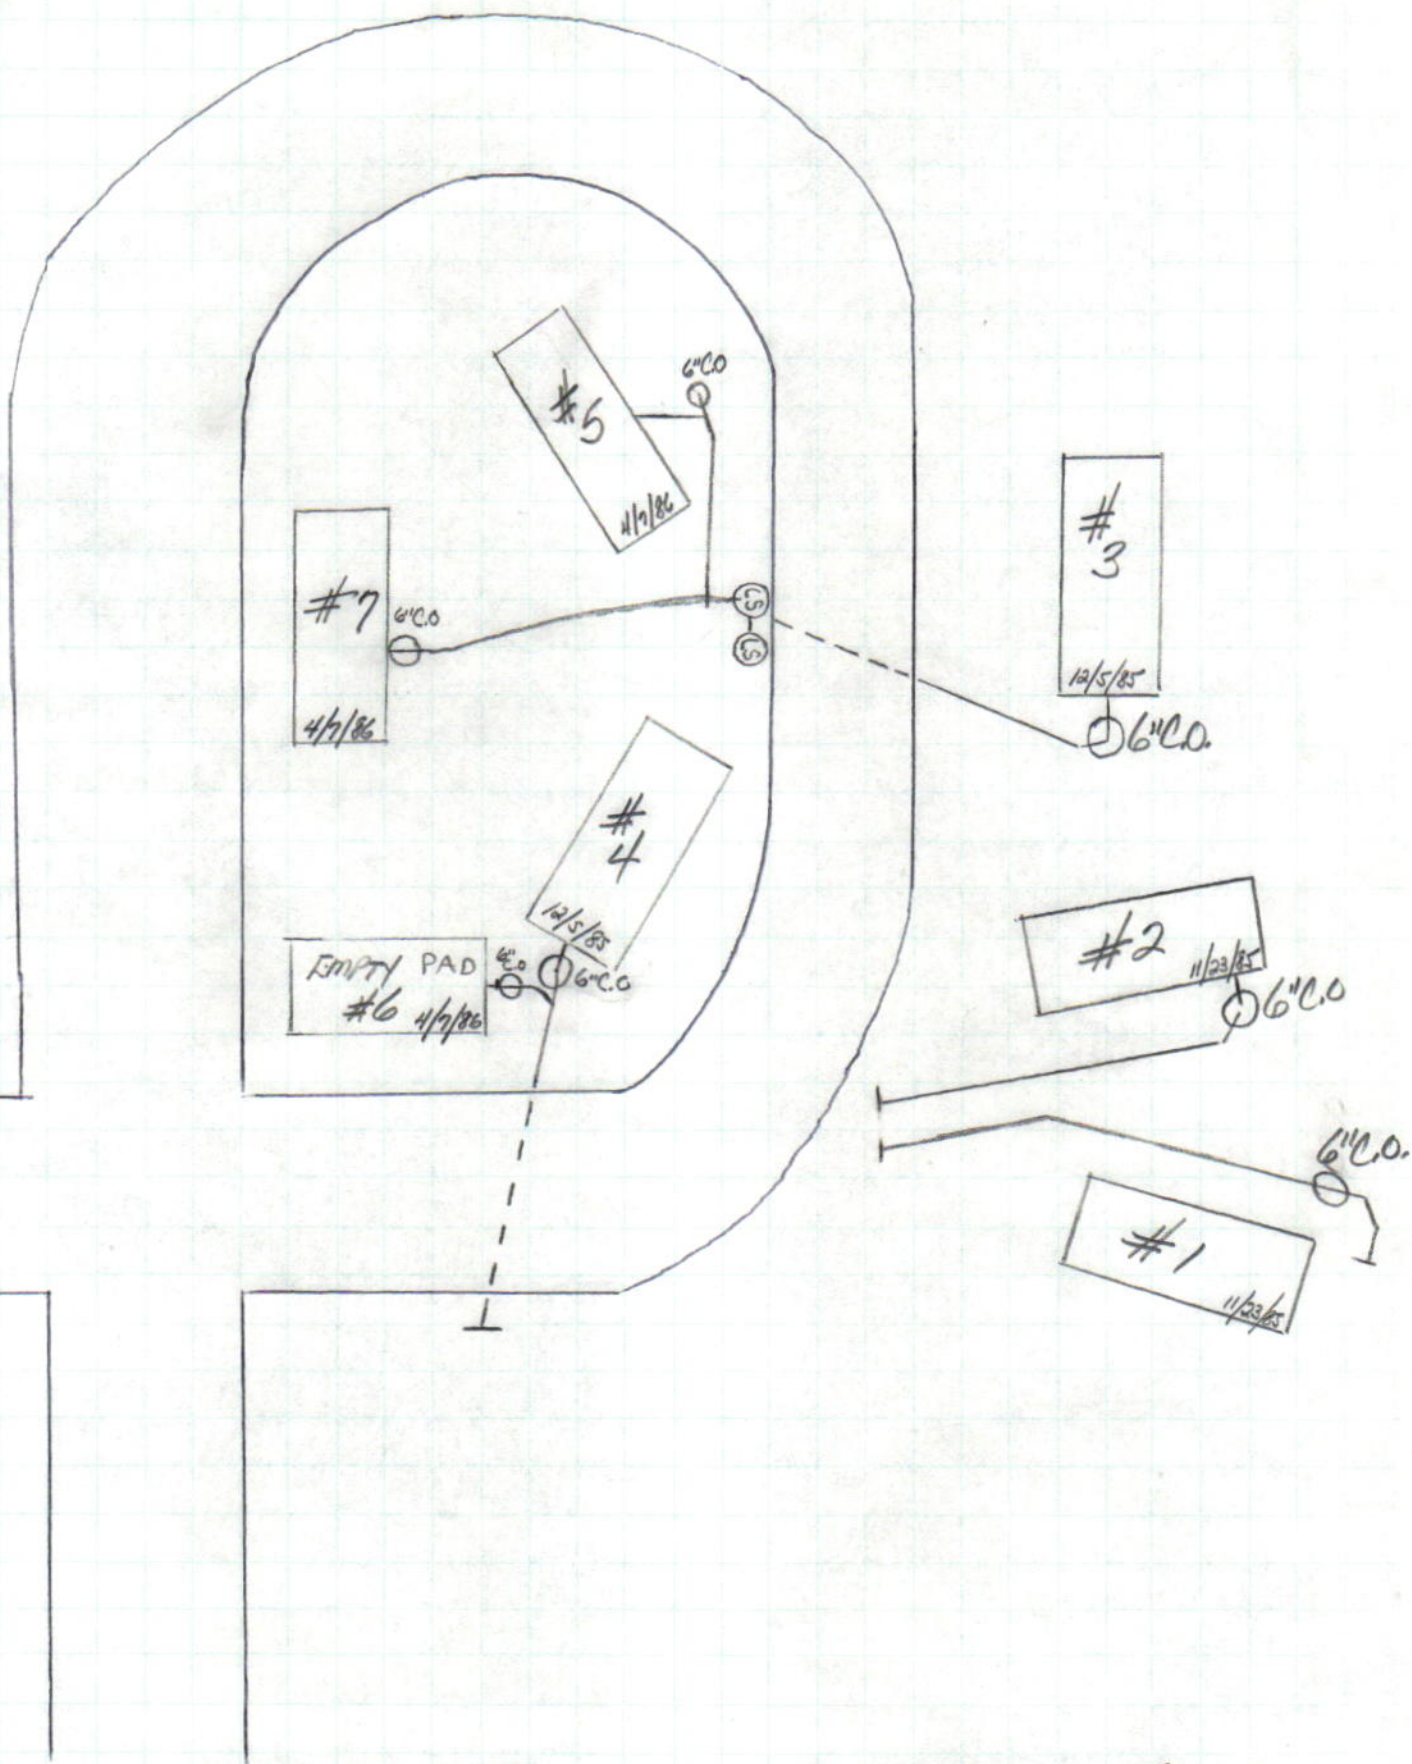

NORTH FENDLETON AVE.

NORTH →