



FALL CREEK REGIONAL WASTE DISTRICT

9378 S. 650 West PO Box 59  
Pendleton, IN 46064-0059 778-7544

add order  
on file

22-30020.00

APPLICATION FOR SEWER PERMIT

Nº 2303

Date 10/24/95

Permit Void 90 days from Date of Issuance

Owner Name Larry Buck

Property Address 113 Bunny Trail

Lot # P.O. Box

Town Pendleton, IN Zip Code 46064

Phone City Water Well ☒

\$ 700.00 Tap on Fee Paid

\$ 25.00 Inspection fee paid


pd \$ 300 1/10/96  
pd \$ 300 2/15/96  
pd \$ 300 3/13/96  
pd \$ 300 4/15/96

Application is hereby made for connection to the Fall Creek Regional Waste District Sewer System for the above listed property - Permit Type: Residential ☒, Commercial ☐, Industrial ☐, or Governmental/Institutional ☐. User Information

All workmanship and materials shall conform to the standards of the District Ordinance as described in Ordinance 84-2 and 84-3 as amended. Acceptance and approval must be made by the District inspector or his duly authorized representative before backfilling and final connection is made to the main sewer lines. Any violation of applicable regulations will cause all lines and appurtenances in violation to be removed and replaced at the owners expense.

The Fall Creek Regional Waste District is responsible for the inspection, approval of materials, and installation techniques only. All costs for materials and installation and any liabilities resulting from same is the sole responsibility of the property owner.

I have read and fully understand the above provisions and agree to comply by said provisions.

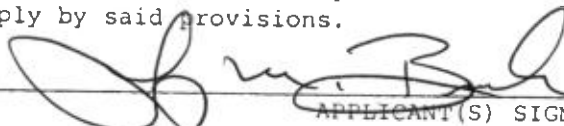  
APPLICANT(S) SIGNATURE

INSPECTOR LA

Date inspected 11/8/95 Approved ☒ Rejected ☐

Reason for rejection

Date reinspected Approved Rejected

Notes:

Size Pipe 6"

Type Pipe SDR 35

Basement Yes No ☒

Sump Pump Yes No ☒

Downspout to Ground Yes No ☒


Septic Tank Pumped & filled Yes No ☒

Contractor Sanders

Special Conditions

Existing Home ☒

New Construction ☐

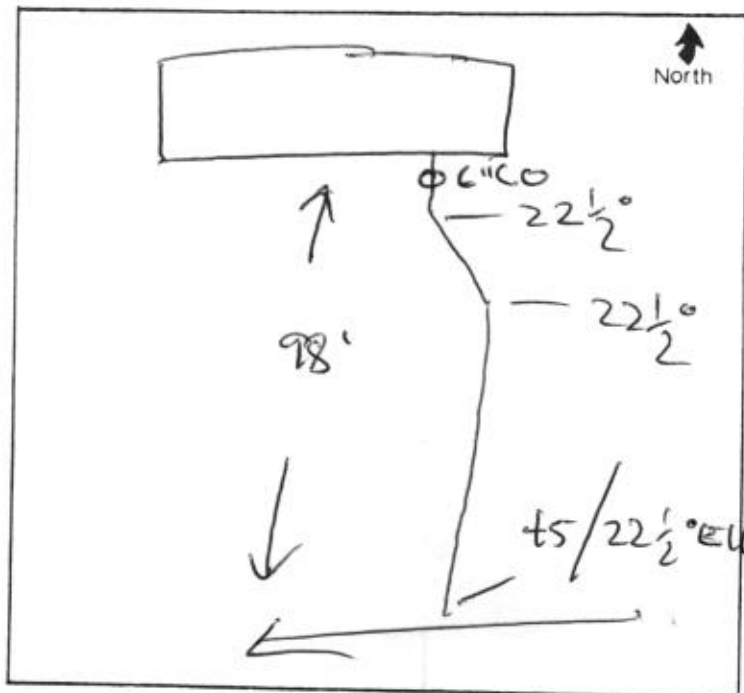





## FALL CREEK REGIONAL WASTE DISTRICT

P.O. Box 59 • 9378 S. 650 West • Pendleton, Indiana 46064-0059 • (317) 778-7544

October 30, 1995

Mrs. Teresa Hutton  
Office Manager

RE: Larry Buck  
113 Bunny Trail  
Pendleton, IN 46064


Dear Teresa,

Mr. Buck has accepted the offer of Watson Excavating, Inc. of \$865.00 to settle the concrete driveway dispute at his residence that resulted from installation of the new sanitary main on Bunny Trail in Old Hickory Hills Subdivision. Please issue a check payable to Mr. Larry Buck in the above amount and I will deliver the check to Mr. Buck and obtain his signature on a Release of Responsibility Form. The \$865.00 should be transferred from the Interceptor Line Extension Fund to our Operating Account. This amount should then be deducted from any final contract payment from FCRWD to Watson Excavating on this project - WO 9310.

For the record, Mr. Buck also agreed to accept an \$800.00 settlement with the District for the removal of two (2) trees and the damage of one (1) tree on his property during this same project.

For accounting purposes, please credit \$800 to Mr. Buck's account towards the \$1300 Line Expansion portion of the \$2,000 Availability Fee leaving a balance due of \$500 to this fund.

The \$700 Plant Expansion portion should be collected in-full and deposited accordingly.

  
J.F. Rowlett  
General Manager

TO: 72242 2A9 142

NO. 2 10 2 1954 10 2

WIT: 1A9

10 2 10 1954

