

Gidw.

PROJECT

Phase II

SHEET

OF

SUBJECT

DATE

8-8-18

JOB NO.

4447

BY


AHAS

113 & 117 in the same trench

113 W. Water

N
↓

117

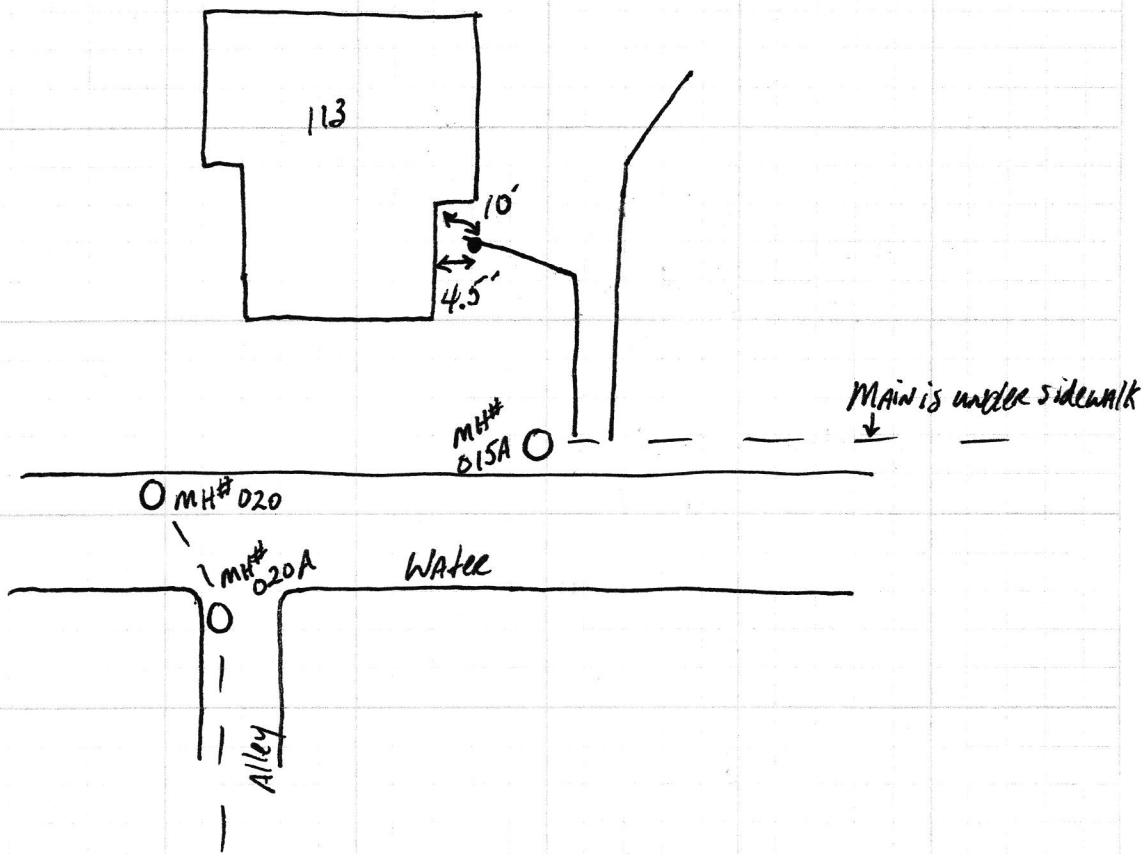

out phase II

8-15-18



113 Water ST (Repair)

4-2019





113 Water ST (Repair)

4-2019