

Gidw.

PROJECT Phase II SHEET _____ OF _____


SUBJECT _____ DATE 7-23-18

JOB NO. 4447

BY Atlas

114 W. Water

N →

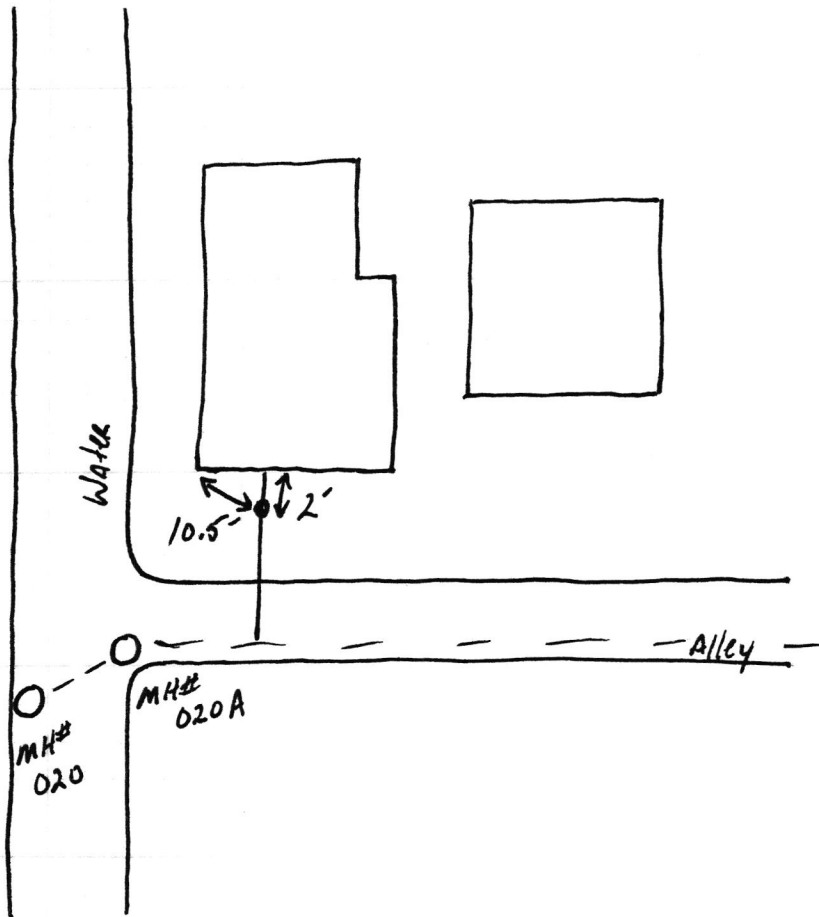

114 W Water

SRT Phase II

7.30.18

