

Gidw.


PROJECT Phase II SHEET _____ OF _____

SUBJECT _____ DATE 4-12-18

JOB NO. 4447

BY Atlas

115 E. Elm

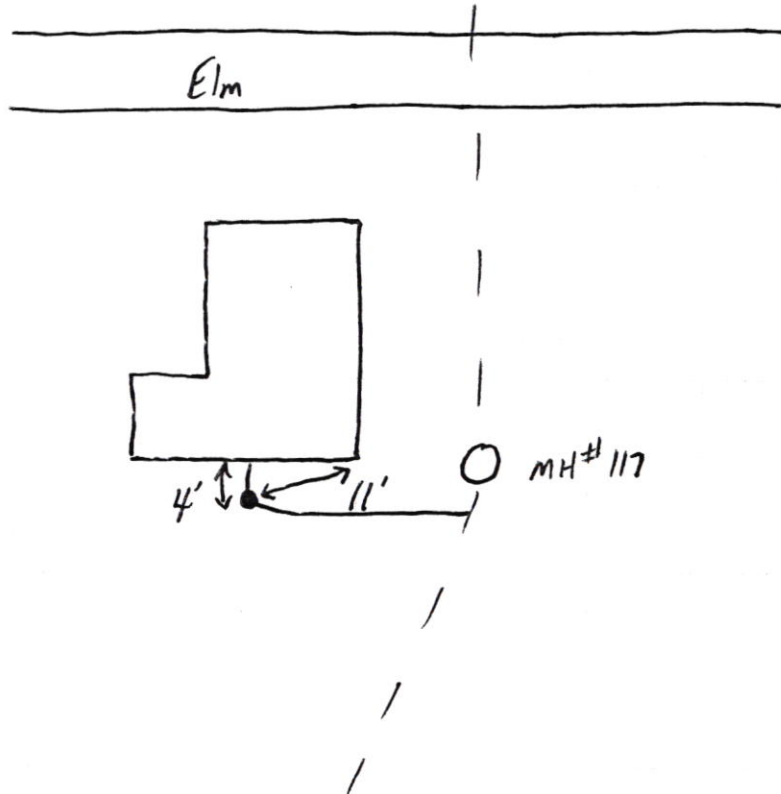

115 Elm

SAP
Phase II

4.20.18

