

Gidw.


PROJECT Phase II SHEET _____ OF _____

SUBJECT _____ DATE 5-7-18

JOB NO. 4447

BY Atlas

115 FRANKLIN

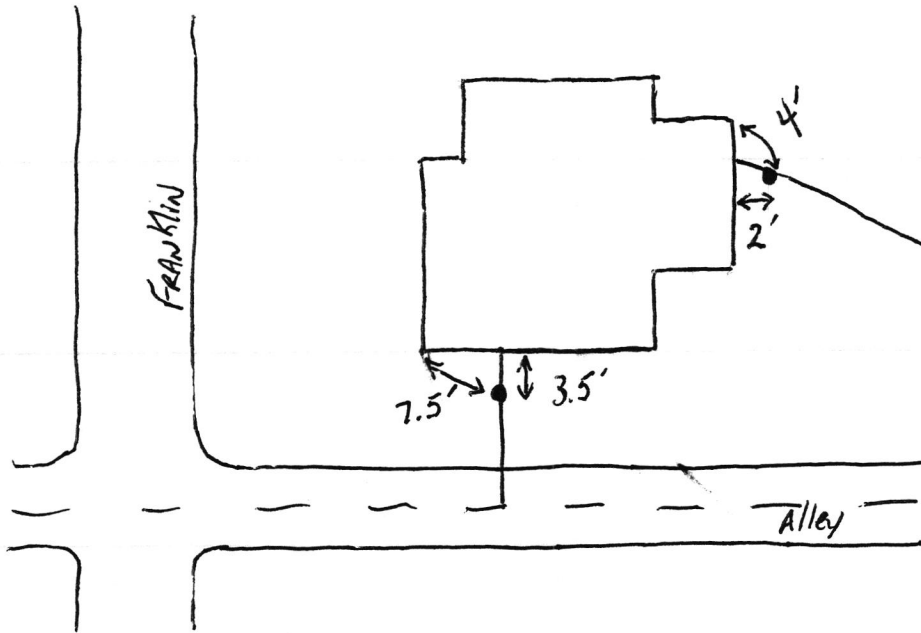

Gidw.


PROJECT Phase II SHEET _____ OF _____

SUBJECT _____ DATE 5-1-18

JOB NO. 4447

BY Atlas

331 - 327 State & 115 Franklin

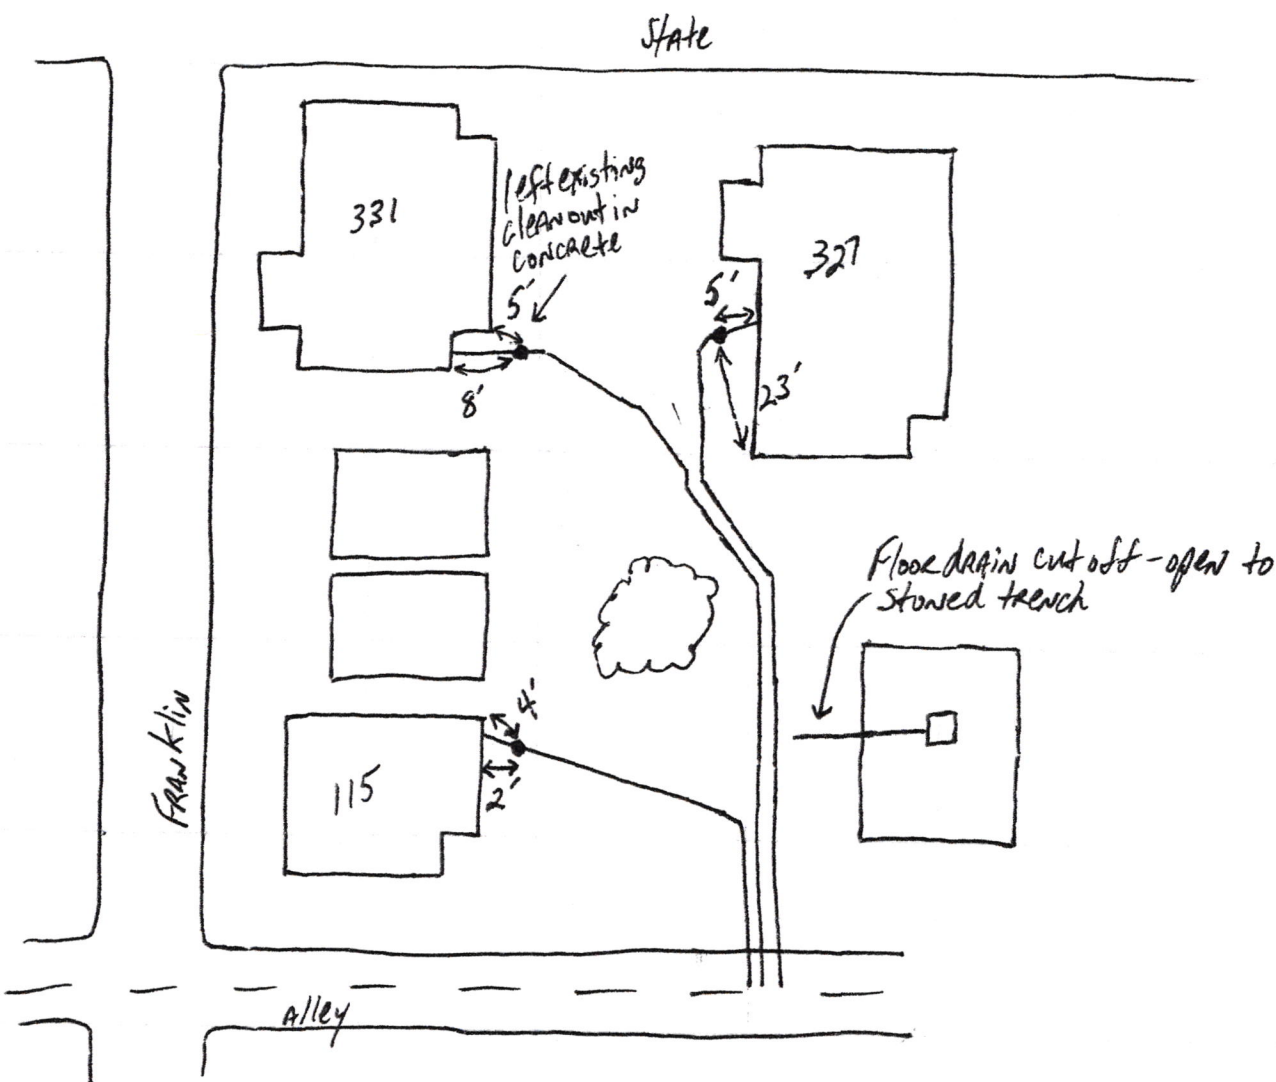

115 Franklin

S.R.P
Phase II

5.3.18



115 Franklin

Srf Phase II

5.14.18

