

G.R.W.


PROJECT Phase II SHEET _____ OF _____

SUBJECT _____ DATE 4-17-18

JOB NO. 4447

BY Atlas

115 S. Adams

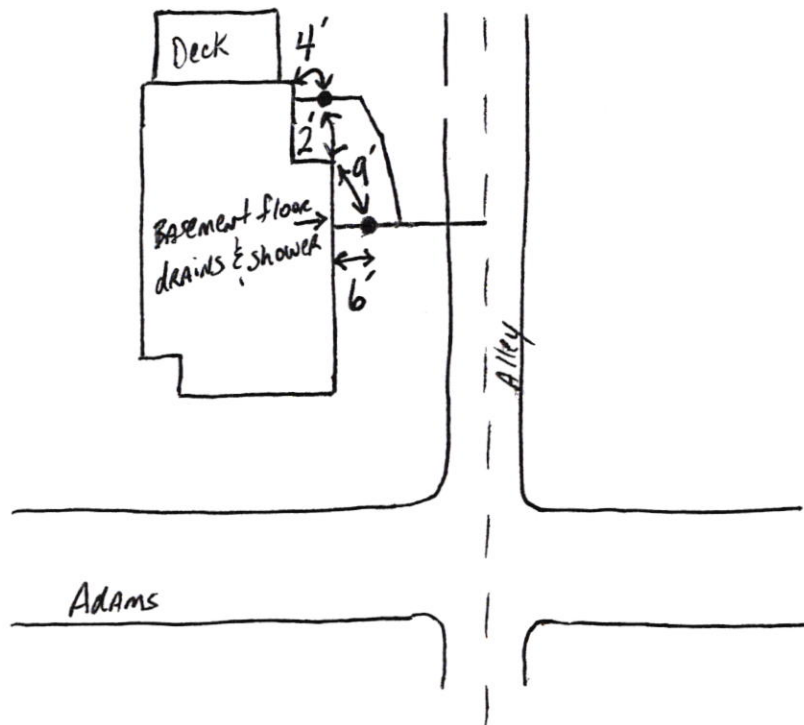

115 S Adams

SRF
Phase II

4.20.18

