


G.R.W.

PROJECT Phase II SHEET _____ OF _____
SUBJECT _____ DATE 8-9-18
JOB NO. 4447
BY Atlas

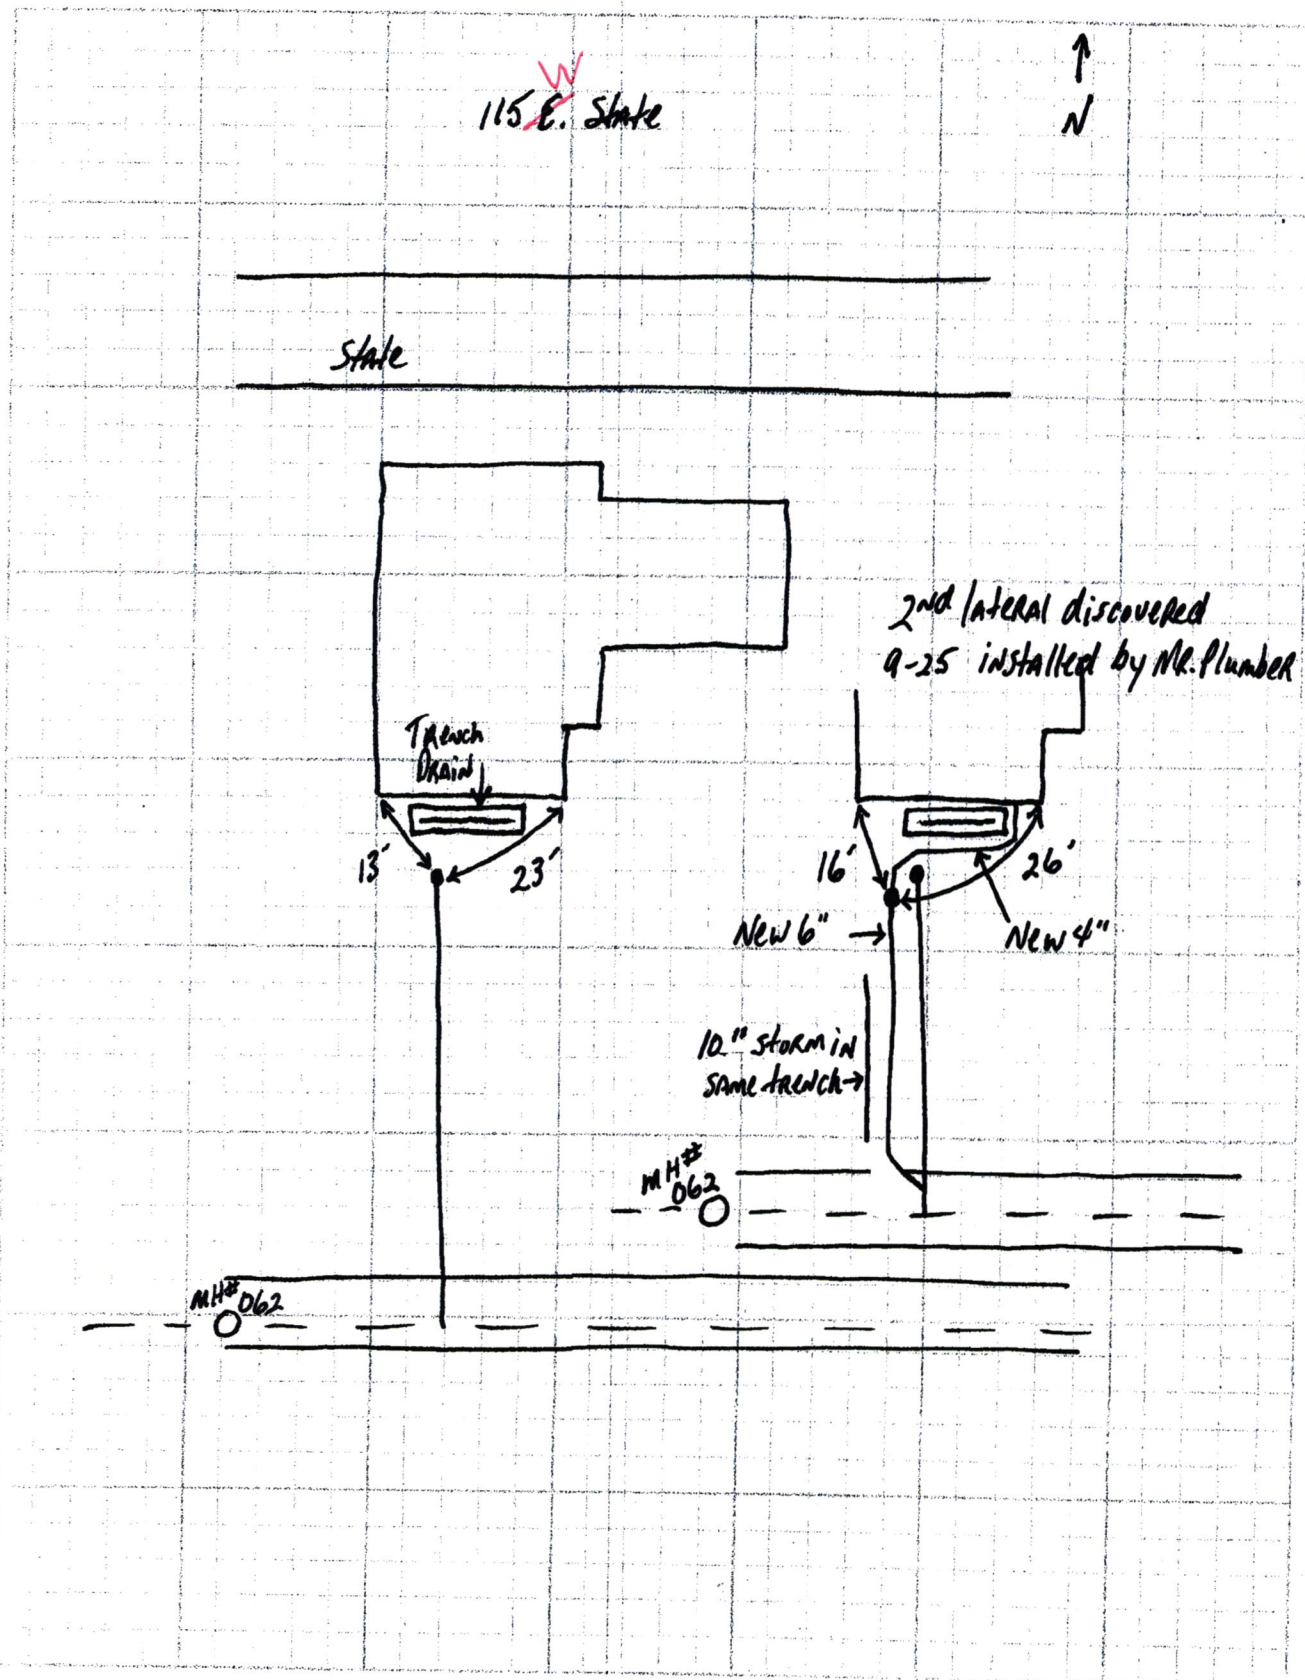

115 W State ST

SRF Phase II



115 W State ST



115 W State ST



115 W State St



115 W State

SRE Phase II

8.15.18



115 W State ST

SRF Phase II

8.9.18



Gidw.

PROJECT

Phase II

SHEET

OF

SUBJECT

DATE

8-9-18

JOB NO.

4447

BY

Atlas

↑
N

115 E. State
W

State

Trench
Drain

13'

23'

MH# 062

