

FALL CREEK REGIONAL WASTE DISTRICT

9378 S 650 WEST, P.O. BOX 59, PENDLETON, IN 46064

765-778-7544

AGREEMENT FOR SANITARY SEWER SERVICE

This Agreement made and entered into this 24 day of August, 2006, between FALL CREEK REGIONAL WASTE DISTRICT ("District") and Mustin Builders ("Applicant") regarding the provision of sanitary sewer service, and the assignment of capacity in, and connection to, the District's facilities for the premises located at Lot 89 Pendle Point

NOW THEREFORE, the parties, in consideration of the mutual promises set out in this Agreement, the receipt and sufficiency of which is hereby acknowledged, agree as follows:

1. The Applicant agrees that all workmanship and materials shall conform to all District ordinances and the District's construction standards. District work and materials before backfilling and final connection is made to the sewer mains. cause all lines and appurtenances in violation to be removed and replaced at the Applicant's expense.
2. The District shall have the right to inspect, repair, or replace any equipment or service on the premises at all reasonable times to determine the cause of service or which has an impact on said service.
3. The Applicant shall be responsible for all capacity charges, and tap fees. The failure to pay any rate charge or fee may result in a lien against the property and/or the termination of service to the property, the cost of which will be borne by Applicant, including, but not limited to, all attorney's fees and collection costs.
4. The District shall not be responsible for any damages as a result of any failure to supply service unless said damages are due to default, neglect or culpability on the part of the District.
5. If there is an available sanitary sewer within three hundred (300) feet of the property line, the property owner shall be required to connect to the District's sanitary sewer system.
6. The Applicant and District agree that the provision of sanitary sewer service touches and concerns the property and the terms of this Agreement bind the District and Applicant and their heirs, executors, administrators, personal representatives, successors, agents, attorneys, assigns, designees, and transferees.

The parties hereto have read and fully understand the above provisions and agree to comply with said provisions.

FALL CREEK REGIONAL WASTE DISTRICT
Rebecca Hunter
Signature

APPLICANT
[Signature]
Signature

STATE OF INDIANA)
COUNTY OF MADISON) SS:


SUBSCRIBED and sworn to before me this 24th day of August, 2006.
My Commission Expires: 4-19-2008

Signature Teresa K Hutton
Printed Teresa K Hutton
Notary Public
Resident of Madison County

INSPECTOR SA DATE INSPECTED 9/15/06 APPROVED ✓ REJECTED _____
REASON FOR REJECTION _____

DATE REINSPECTED _____ APPROVED _____ REJECTED _____

NOTES:
SIZE PIPE 6" TYPE PIPE 35
BASEMENT YES NO
SUMP PUMP YES NO
DOWNSPOUT TO GROUND YES NO
SEPTIC TANK PUMPED & FILLED YES NO
CONTRACTOR Balton E
SPECIAL CONDITIONS _____
EXISTING HOME _____
NEW CONSTRUCTION ✓

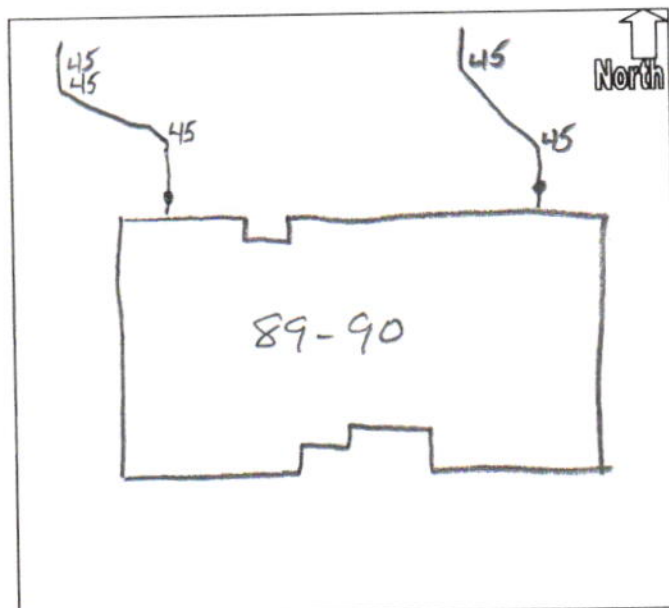



MUSTIN BUILDERS, INC.

810 CENTRAL AVENUE

ANDERSON, IN 46012

PH. 765-644-8502

KEYBANK NATIONAL ASSOCIATION

CLEVELAND, OHIO 44114

56-704-412

055548

Five Thousand Two Hundred Seventy ⁰⁰/₁₀₀

DATE

8-24-06

CHECK NO.

055548

AMOUNT

5270.⁰⁰/₁₀₀

PAY

TO THE

ORDER

OF

Fall Creek REGIONAL WASTE



AUTHORIZED SIGNATURE

MP

"055548"