

Gidw.

PROJECT

Phase II

SHEET

OF

SUBJECT

DATE

7-17-18

JOB NO.


4447

BY

Atlas

116 J. Caroline

↑
N'

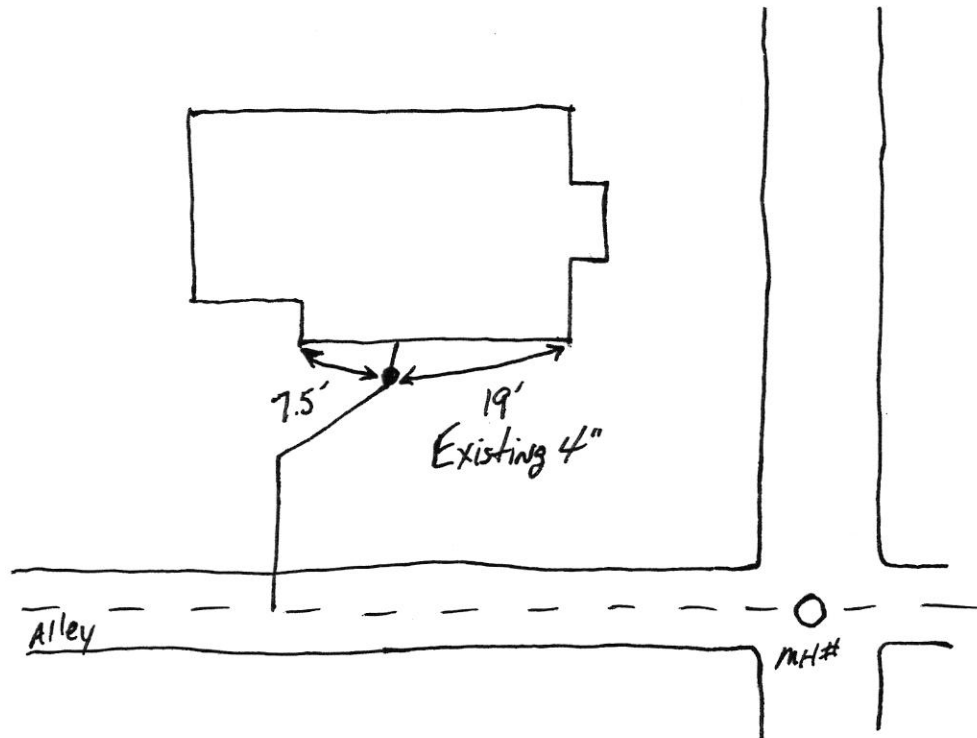

116 Caroline

SAT Phase II

7.18.18

