


Gidw.

PROJECT Phase II SHEET _____ OF _____
SUBJECT _____ DATE 8-1-18
JOB NO. 4447
BY Atlas

211 Pendleton / 113 & 115 Oak / 117 & 119 Oak N →



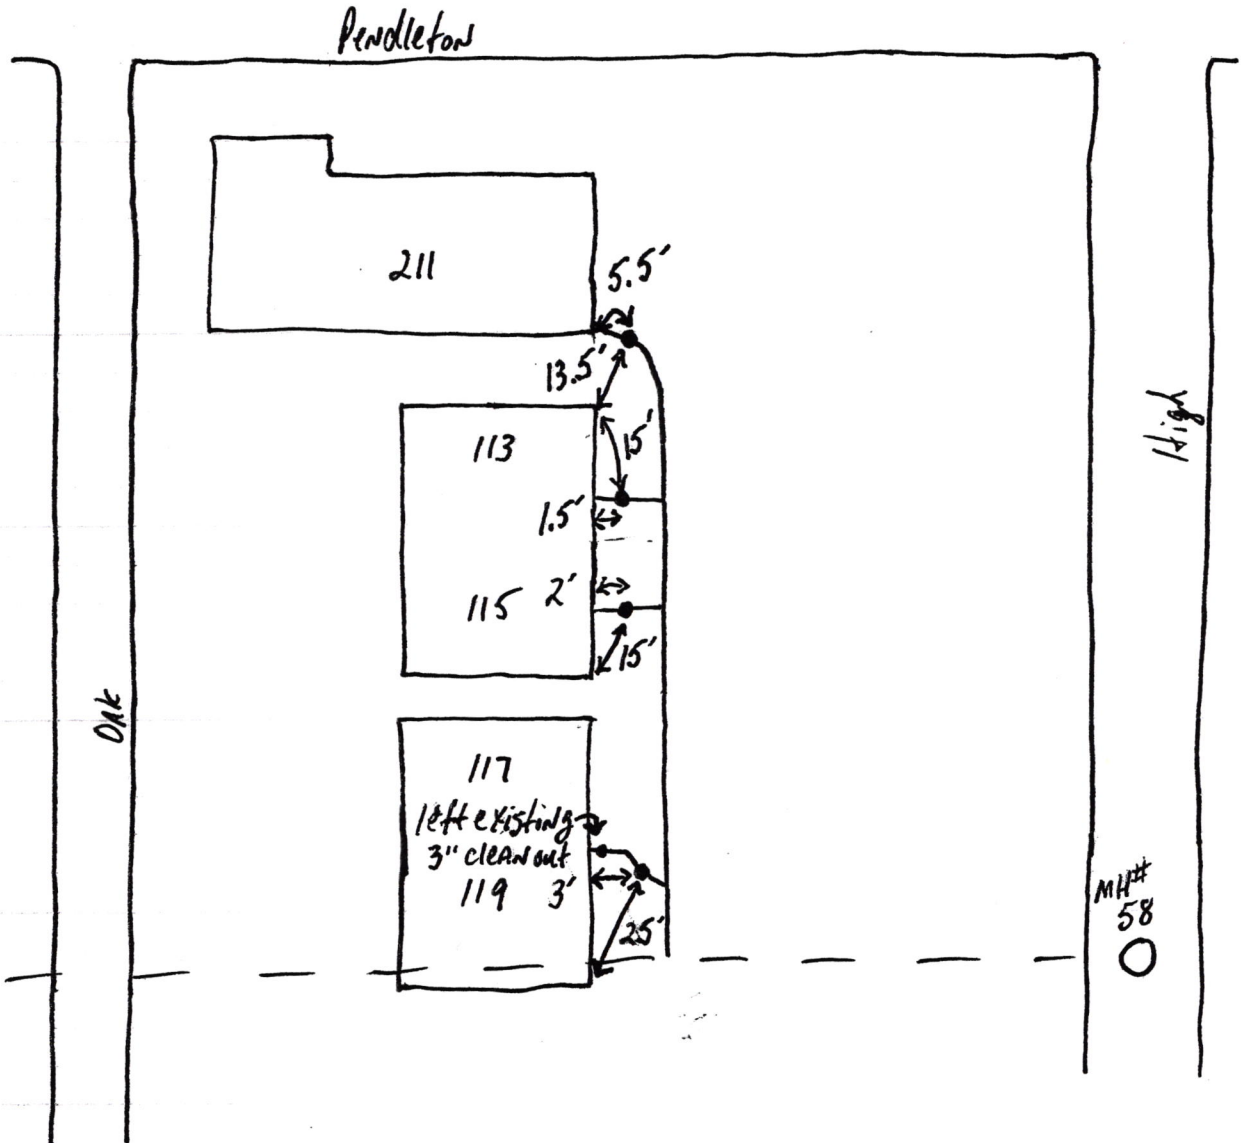

11.11.18

2K Phase 1

8.15.18