

Fall Creek Regional Waste District
9378 S 650 W, P.O. Box 59, Pendleton, IN 46064
765-778-7544

#7254

Agreement for Sanitary Sewer Service

This Agreement made and entered into this 17 day of July, 2024, between Fall Creek Regional Waste District ("District") and D.R. Horton ("Applicant") regarding the provision of sanitary sewer service, and the assignment of capacity in and connection to, the District's facilities for the premises located at Carrick Glen Lot 36.

Street Address: 117 Carrick Glen Blvd

Now therefore, the parties, in consideration of the mutual promises set out in this Agreement, the receipt and sufficiency of which is hereby acknowledged, agree as follows:

- 1. The Applicant agrees that all workmanship and materials shall conform to all District ordinances and the District's construction standards. District must accept and approve all work and materials before backfilling and final connection is made to the sewer mains. Any violation of this provision will cause all lines and appurtenances in violation to be removed and replaced at the Applicant's expense.
2. The District shall have the right to enter upon the Applicant's premises at all reasonable times to inspect, repair, or replace any equipment used in connection with the District's service or which has an impact on said service.
3. The Applicant shall be responsible for all monthly user rates, capacity charges, and tap fees. The failure to pay any rate charge or fee may result in a lien against the property and/or the termination of service to the property, the cost of which will be borne by Applicant, including, but not limited to, all attorney's fees and collection costs.
4. The District shall not be responsible for any damages as a result of any failure to supply service unless said damages are due to default, neglect or culpability on the part of the District.
5. If there is an available sanitary sewer within three hundred (300) feet of the property line, the property owner shall be required to connect to the District's sanitary sewer system.
6. The Applicant and District agree that the provision of sanitary sewer service touches and concerns the property and the terms of this Agreement bind the District and Applicant and their heirs, executors, administrators, personal representatives, successors, agents, attorneys, assigns, designees, and transferees.

The parties hereto have read and fully understand the above provisions and agree to comply with said provisions.

FALL CREEK REGIONAL WASTE DISTRICT
Signature [Signature]

APPLICANT
Signature [Signature]


STATE OF INDIANA)
) SS:
COUNTY OF MADISON)

SUBSCRIBED and sworn to before me this ___ day of ___, 20__

My Commission Expires: Signature
Printed
Notary Public
Resident of ___ County

Inspector Kyle Date Inspected 8/12/24 Approved [check] Rejected
Reason for Rejection
Date Reinspected Approved Rejected

Notes:
Size Pipe 6" Type Pipe SDR 35
Basement Yes No
Sump Pump Yes No
Downspout to Ground Yes No
Septic Tank Pumped & Filled Yes No
Contractor Wills Exv.
Special Conditions
Existing Home
New Construction [check]

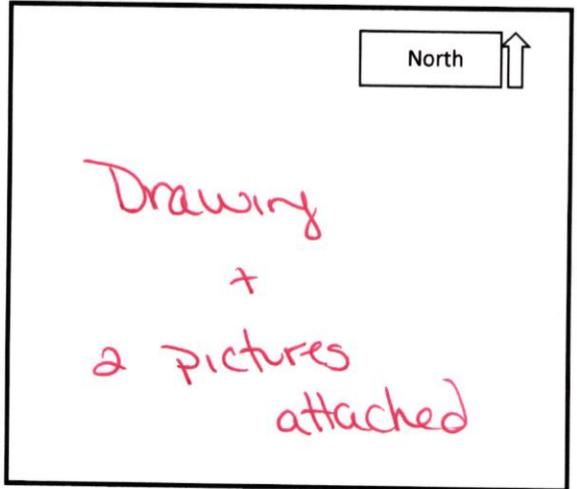



STOEPPELWERTH

ALWAYS ON

7965 East 106th Street, Fishers, IN 46038-2505
phone: 317.849.5935 fax: 317.849.5942

JOB ID CARG1A.36



CONTROL# 112379 DRH

117 CARRICK GLEN BOULEVARD
PENDLETON, IN 46064

1" = 30'

LOT AREA: 10,344 Sq. Ft.

DESIGN PAD=871.6
AS-BUILT PAD=871.5
LOT COVERAGE=17.3%
M.L.A.G.=872.2
M.F.F.=872.7

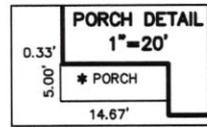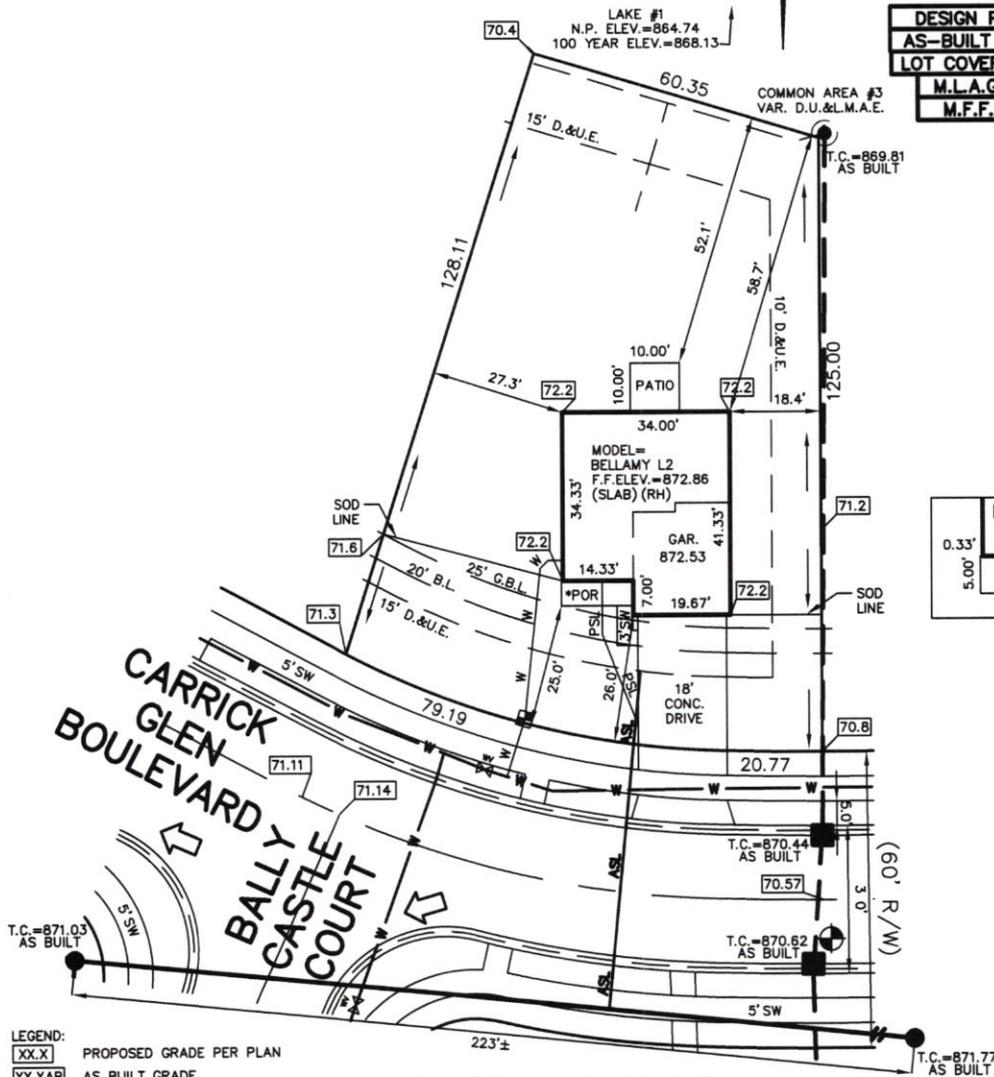

- LEGEND:**
- XX.X PROPOSED GRADE PER PLAN
 - XX.XAB AS BUILT GRADE
 - S.S.D. SUB-SURFACE DRAIN
 - AS SANITARY SEWER
 - PSL 6" AS BUILT SANITARY LATERAL
 - 6" PROPOSED SANITARY LATERAL
 - W STORM SEWER
 - 3/4" WATER CONNECTION
 - W WATER MAIN
 - SW SWALE
 - SANITARY MANHOLE
 - STORM MANHOLE
 - CURB INLET
 - ⊕ FIRE HYDRANT
 - WATER METER
 - ⊗ WATER VALVE
 - ← EMERGENCY FLOOD ROUTE
 - VAR. VARIABLE DRAINAGE UTILITY
 - D.U. DRAINAGE UTILITY
 - L.M.A.E. LANDSCAPE, MAINTENANCE ACCESS EASEMENT
 - D.&U.E. DRAINAGE & UTILITY EASEMENT
 - B.L. BUILDING LINE
 - G.B.L. GARAGE BUILDING LINE
 - M.L.A.G. MINIMUM LOWEST ADJACENT GRADE
 - M.F.F. MINIMUM FINISHED FLOOR

CONTRACTOR SHALL CUT 10' OFF OF LATERAL AND BEGIN FROM THAT POINT AND CONNECT TO HOUSE FOLLOWING PLOT PLAN.

BENCHMARK
TOP OF CASTING=870.62

ALL UNDERGROUND SEWERS AND UTILITIES SHOWN ARE PLOTTED BY SCALE FROM "RECORD DRAWINGS" FURNISHED BY ENGINEER.

SOD: 2,938 ± Sq. Ft.
SEEDING: 6,222 ± Sq. Ft.
CONC. DRIVEWAY: 767 ± Sq. Ft.
PRIVATE WALK: 28 ± Sq. Ft.
PUBLIC WALK: 446 ± Sq. Ft.

LOT 36
CARRICK GLEN SECTION 1A
INST. #2020R008747
ZONING: SINGLE FAMILY
5' MINIMUM SIDE YARD
15' MINIMUM REAR YARD
50% MAXIMUM LOT COVERAGE




David J. Stoepfelwerth

NOTE: THIS DRAWING IS FOR PERMITTING PURPOSES ONLY AND NOT INTENDED TO BE REPRESENTED AS A RETRACEMENT SURVEY, ORIGINAL SURVEY, ROUTE SURVEY, LOT SURVEY OR A SURVEYOR LOCATION REPORT OR ANY OTHER TYPE OF PROPERTY BOUNDARY ASSESSMENT. NO BOUNDARY CORNERS HAVE BEEN SET AND THEREFORE NO LIABILITY WILL BE ASSUMED FOR ANY USE OF THIS DATA FOR CONSTRUCTION OF NEW IMPROVEMENTS INCLUDING FENCES.

08/14/24 JRS



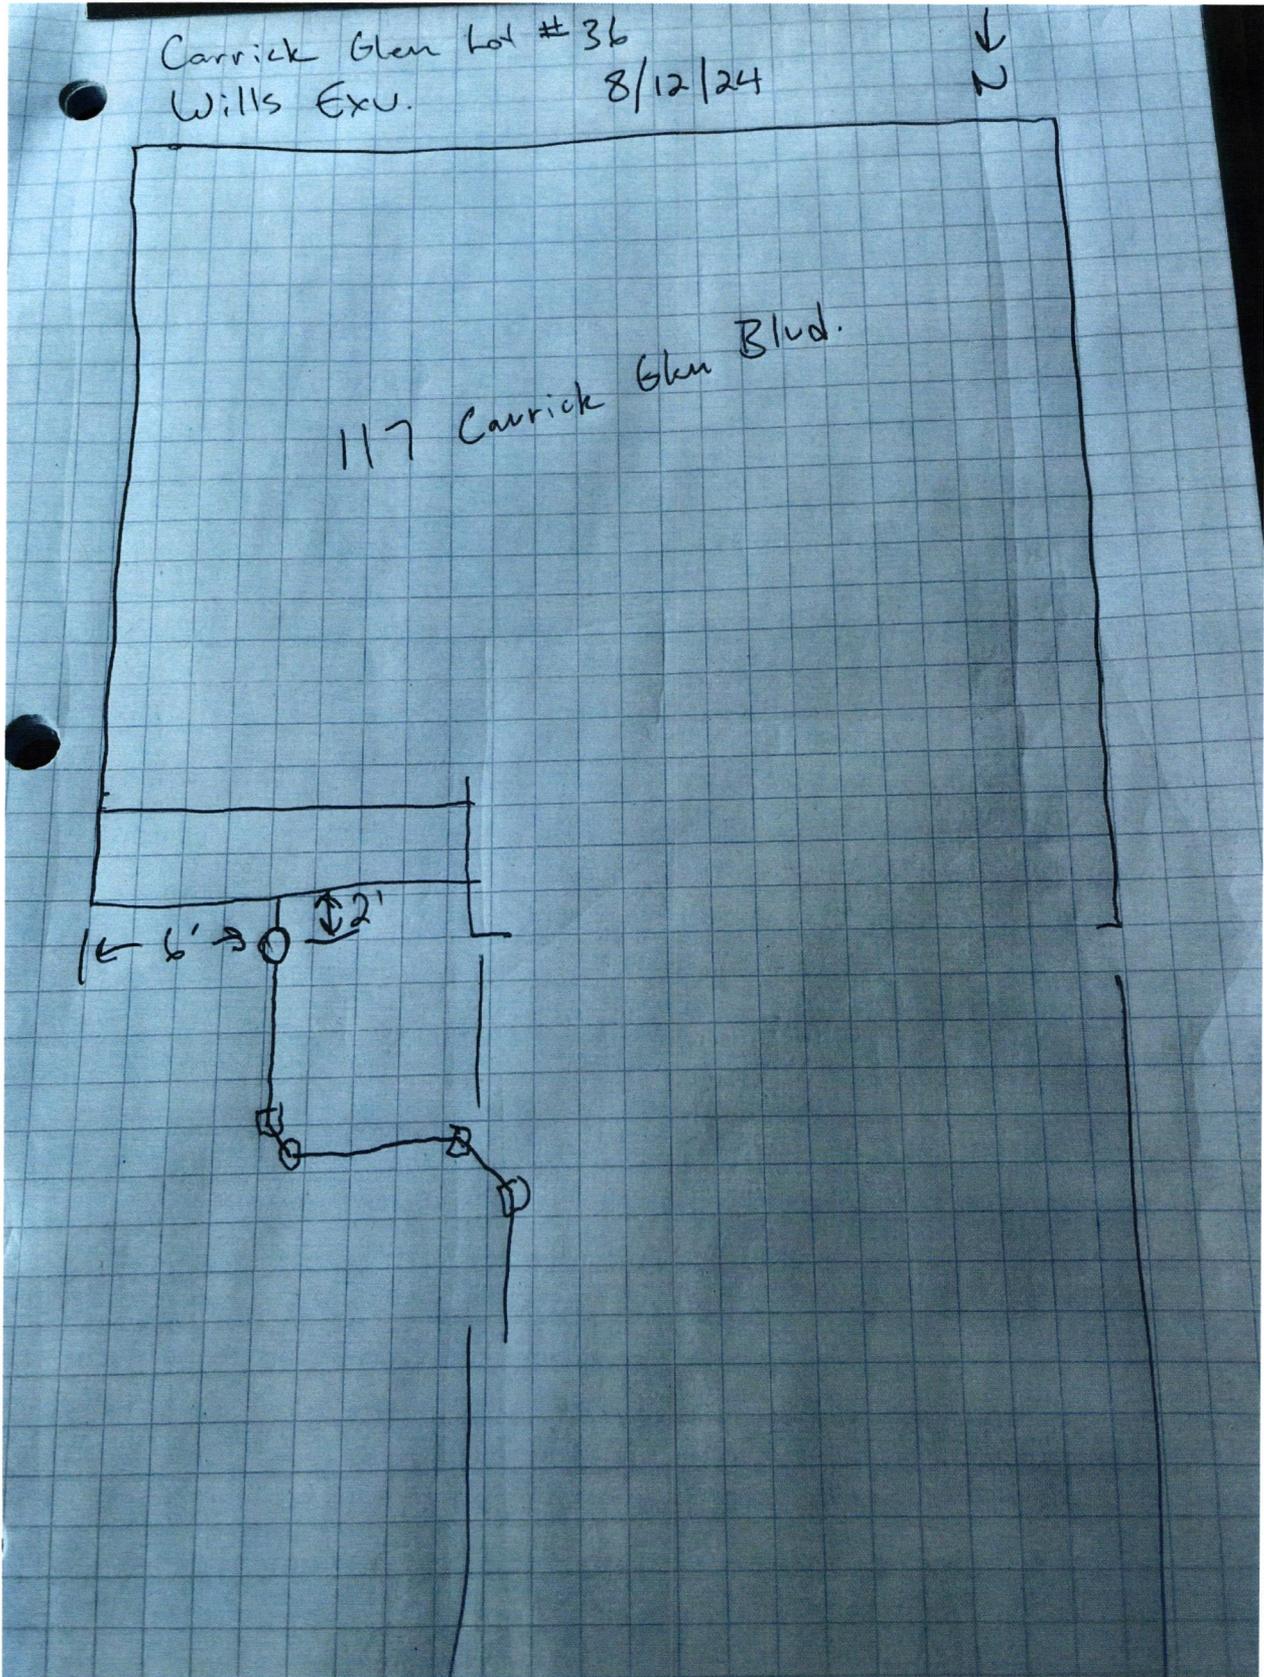





THIS CHECK IS PRINTED IN RED AND BLUE INK ON THE FACE ON CHEMICAL AND BLEACH REACTIVE PAPER WITH INVISIBLE FLUORESCENT FIBERS AND BASKETWEAVE ON BACK **MP**

DR HORTON
America's Builder

JP Morgan Chase Bank, N.A.
Syracuse, NY

Check Number **1770255**

DRH Inc. Controlled Dish
1341 Horton Circle
Arlington, TX 76011

50-937
213
2720128

Date	Amount
10/02/23	\$*****4,160.00

Void after 6 months from date of issue

FOUR THOUSAND ONE HUNDRED SIXTY AND 00/100 *****

Pay To The Order Of:
FALL CREEK REGIONAL WASTE DISTRICT
9378 SOUTH 650 WEST
PENDLETON IN 46064

D. L. Horton

Rec# 0126446

overpaid

*only owed tap fee
of \$760.00*

*Use credit towards
other lots*

3