


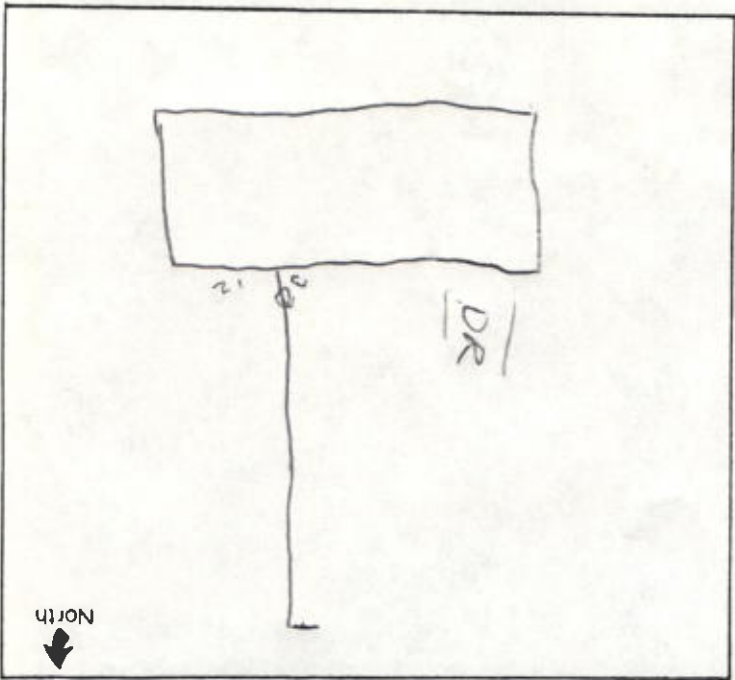

Notes:
Size Pipe 6
Type Pipe PVC
Basement Yes NO X
Sump Pump Yes NO X
Downspout to Ground Yes NO X
Septic Tank Pumped & Filled Yes NO X
Contractor Bolton
Special Conditions
Existing Home
New Construction X

Date reinspected _____ Approved _____ Rejected _____

Date inspected 1-16-00 Approved V Rejected _____
Reason for rejection _____

INSPECTOR B. D. M.

APPLICANT(S) SIGNATURE _____

I have read and fully understand the above provisions and agree to comply by said provisions.
The Fall Creek Regional Waste District is responsible for the inspection, approval of materials, and installation techniques only. All costs for materials and installation and any liabilities resulting from same is the sole responsibility of the property owner.
All workmanship and materials shall conform to the standards of the District Ordinance as described in Ordinance 84-2 and 84-3 as amended. Acceptance and approval must be made by the District inspector or his duly authorized representative before backfilling and final connection is made to the main sewer lines. Any violation of applicable regulations will cause all lines and appurtenances in violation to be removed and replaced at the owners expense.
Application is hereby made for connection to the Fall Creek Regional Waste District Sewer System for the above listed property - Permit Type: Residential, Commercial, Industrial, or Governmental/Institutional. User Information _____

Owner Name: Murray Builders - Nancy Stanley
Property Address: 117 W. Estate St
Lot # 70, Village Colony P.O. Box
Town: Anderson
Phone: 765-644-8502
City Water: _____
IN Zip code: 46013
Well: _____
Tap on Fee Paid: \$2556.00
Inspection fee paid: \$
Date: 1-5-2000
Permit Void 90 days from Date of Issuance

APPLICATION FOR SEWER PERMIT
No 2724



FALL CREEK REGIONAL WASTE DISTRICT

9378 S. 650 West PO Box 59
Pendleton, IN 46064-0059 778-7544

22-156 15.00

data order
or file