

Gidw.

PROJECT

Phase II

SHEET

OF

SUBJECT

DATE


8-7-18


JOB NO

4447

BY

Atlas

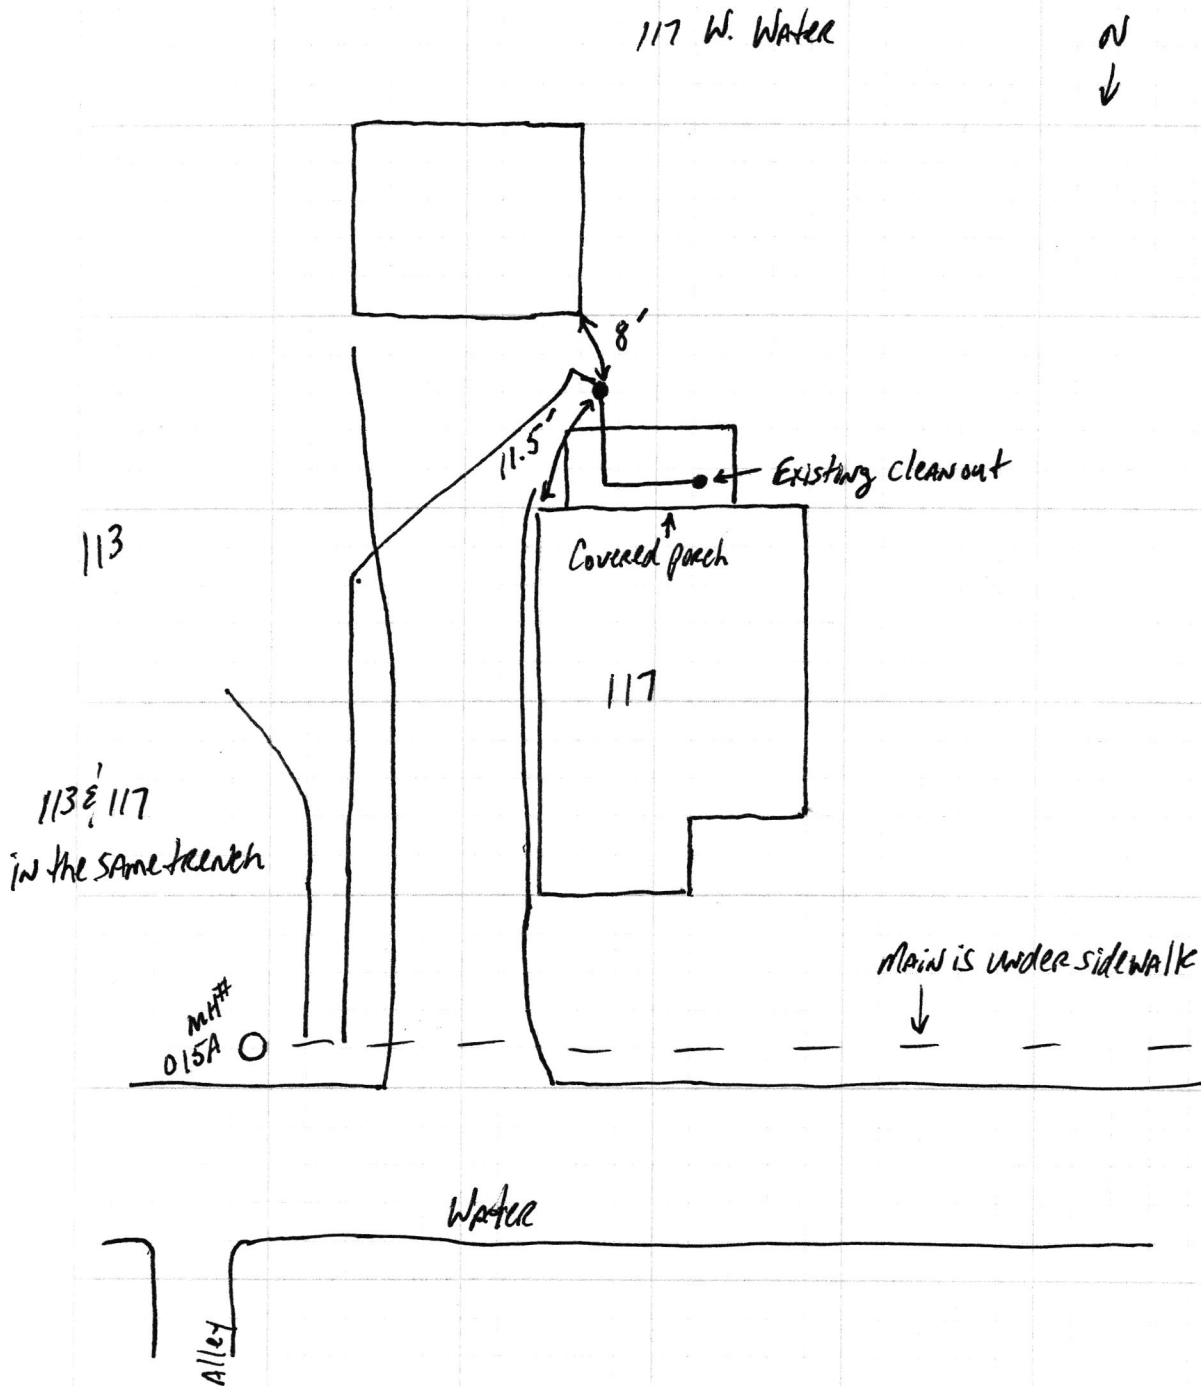

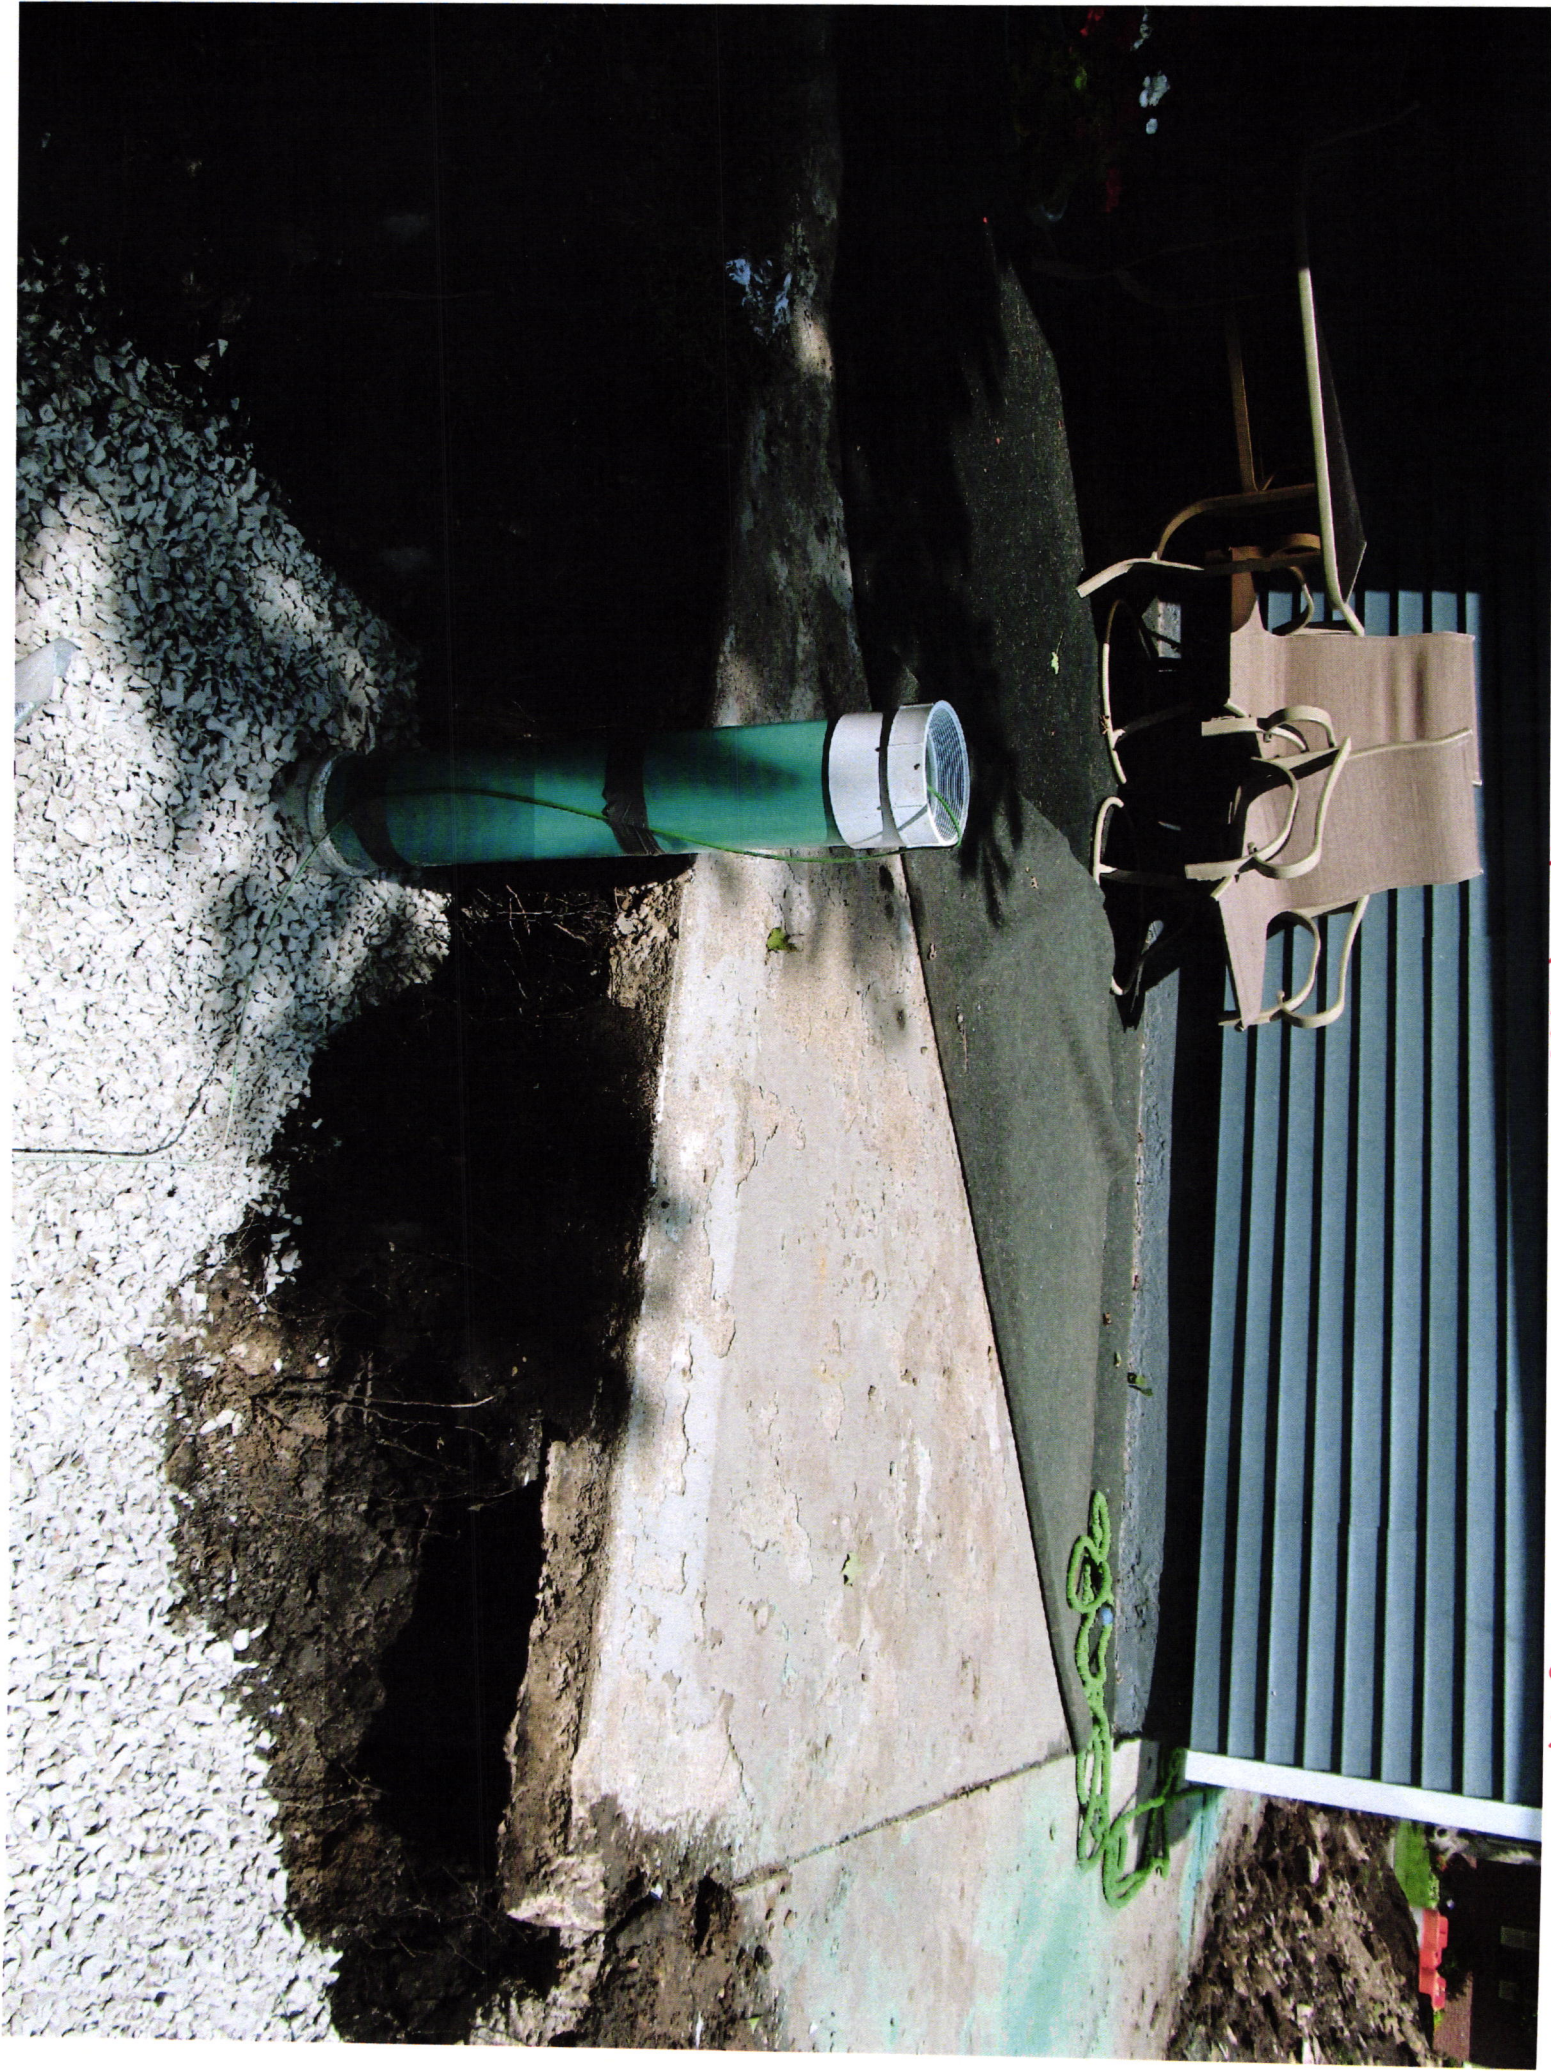

OK phase II

8.15.19