


Gidw.

PROJECT Phase II SHEET _____ OF _____

SUBJECT _____ DATE 5-9-18

JOB NO. 4447

BY Atlas

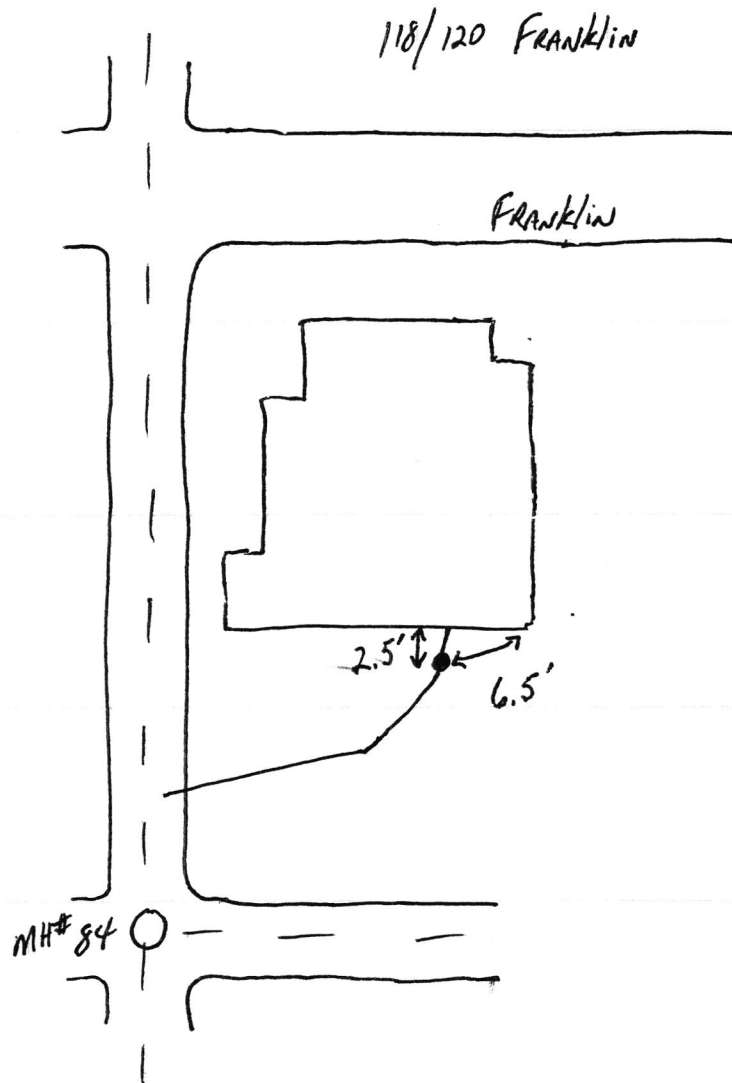

118-120 Franklin

SAC Phase II

5.14.18

