

#6447

Agreement for Sanitary Sewer Service

Now therefore, the parties, in consideration of the mutual promises set out in this Agreement, the receipt and sufficiency of which is hereby acknowledged, agree as follows:

1. The Applicant agrees that all workmanship and materials shall conform to all District ordinances and the District's construction standards. District must accept and approve all work and materials before backfilling and final connection is made to the sewer mains. Any violation of this provision will cause all lines and appurtenances in violation to be removed and replaced at the Applicant's expense.
2. The District shall have the right to enter upon the Applicant's premises at all reasonable times to inspect, repair, or replace any equipment used in connection with the District's service or which has an impact on said service.
3. The Applicant shall be responsible for all monthly user rates, capacity charges, and tap fees. The failure to pay any rate charge or fee may result in a lien against the property and/or the termination of service to the property, the cost of which will be borne by Applicant, including, but not limited to, all attorney's fees and collection costs.
4. The District shall not be responsible for any damages as a result of any failure to supply service unless said damages are due to default, neglect or culpability on the part of the District.
5. If there is an available sanitary sewer within three hundred (300) feet of the property line, the property owner shall be required to connect to the District's sanitary sewer system.
6. The Applicant and District agree that the provision of sanitary sewer service touches and concerns the property and the terms of this Agreement bind the District and Applicant and their heirs, executors, administrators, personal representatives, successors, agents, attorneys, assigns, designees, and transferees.

The parties hereto have read and fully understand the above provisions and agree to comply with said provisions.

Rebecca J. McClintick
Signature

Signature

[illegible]

SUBSCRIBED and sworn to before me this 25th day of JUNE, 20 12

My Commission Expires:

Signature Rebecca L. McClintock



Commission Expires May 19, 2016

A Resident of Printed

Madison County, Indiana

Rebecca A. McClintick, Notary Public

Notary Public

Resident of _____ County _____

Inspector 1- Date Inspected 3-5-13 Approved ☒ Rejected ☐

Reason for Rejection

Date Reinspected _____ Approved _____ Rejected _____

Notes:

Size Pipe 4 1/2 Type Pipe SDR 35 / 160 PSI

Basement Yes No ☒

Sump Pump Yes No ☒

Downspout to Ground Yes ☒ No ☐


Septic Tank Pumped & Filled Yes No

Contractor DALE MERCER

Special Conditions

Existing Home

New Construction ☒

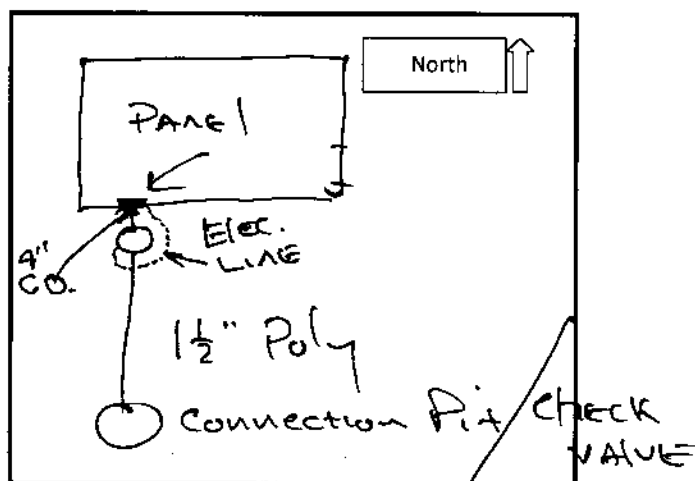

DAVID L MERCER
SARA L HOLDEN
617 SPRING MILL RD
ANDERSON, IN 46013-3745

2103

70-2189/719
059

6-25-2012

Date

Pay to the
Order of

FCRWD

\$ 5030.64

FIVE THOUSAND AND THIRTY DOLLARS &

64/100

Security
Features
Details on
Back

 PNC BANK

PNC Bank, N.A. 071

For

David L Mercer

⑆071921891⑆

2103

Harland Clarke