


Gidw.

PROJECT Phase II SHEET _____ OF _____

SUBJECT _____ DATE 4-18-18

JOB NO. 4447

BY Atlas

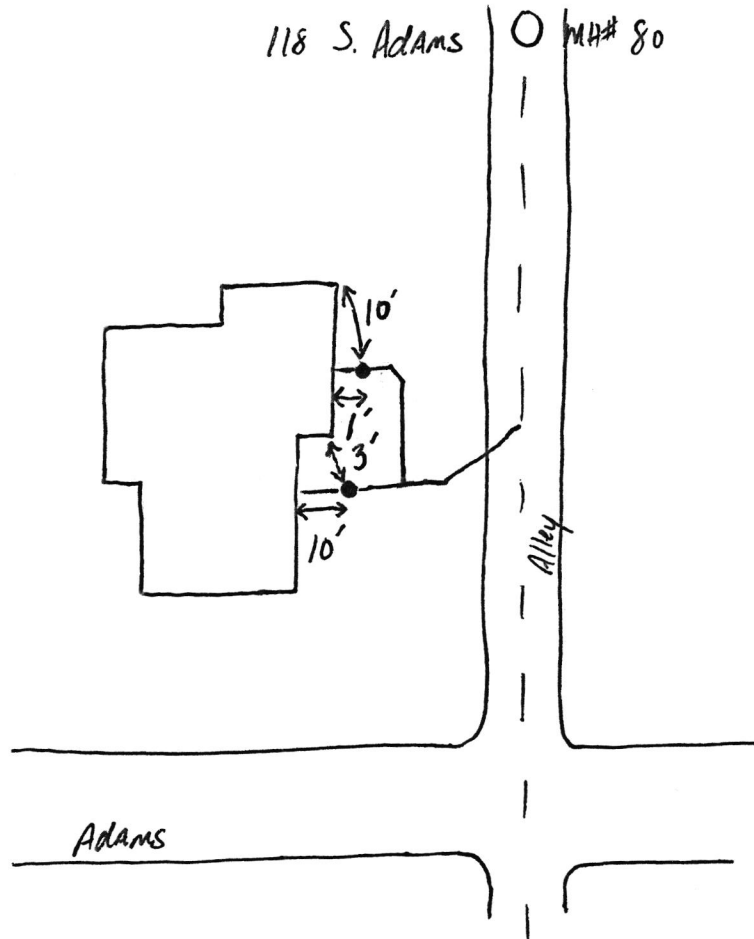

118 S Adams

S&F
Phase II

4-20-18

