

Side


PROJECT Phase II SHEET _____ OF _____

SUBJECT _____ DATE 5-7-18

JOB NO. 4447

BY Atlas

119 Franklin

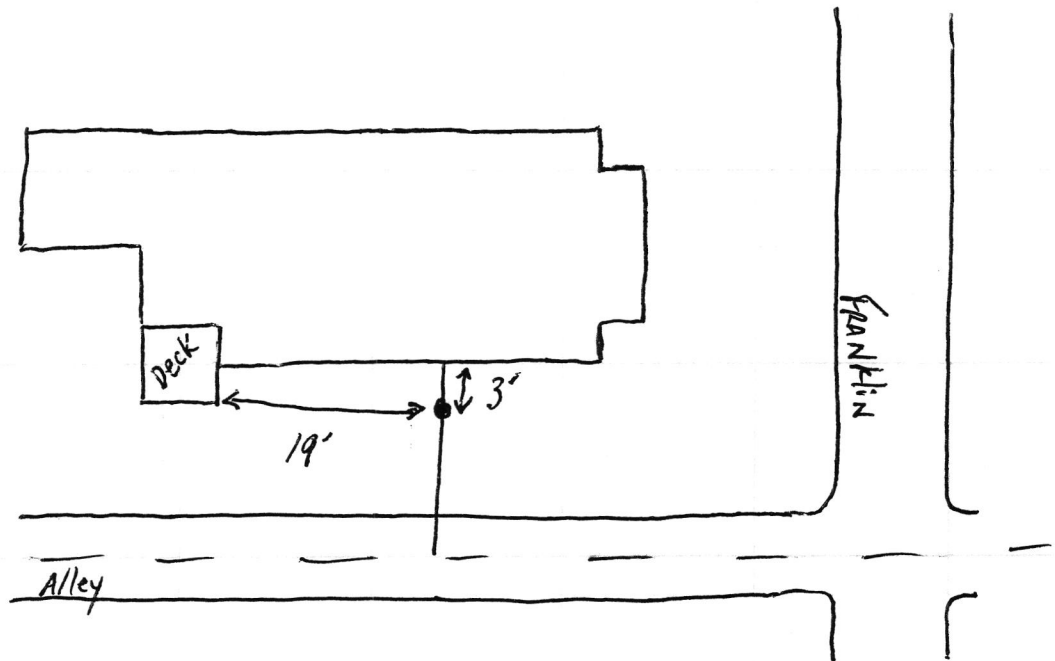

119 S Franklin

SF Phase II

5-14-18

