

Gidw.

PROJECT Phase II SHEET _____ OF _____


SUBJECT _____ DATE 7-27-18

JOB NO. 4447

BY Atlas

119 N. Pendleton

← N

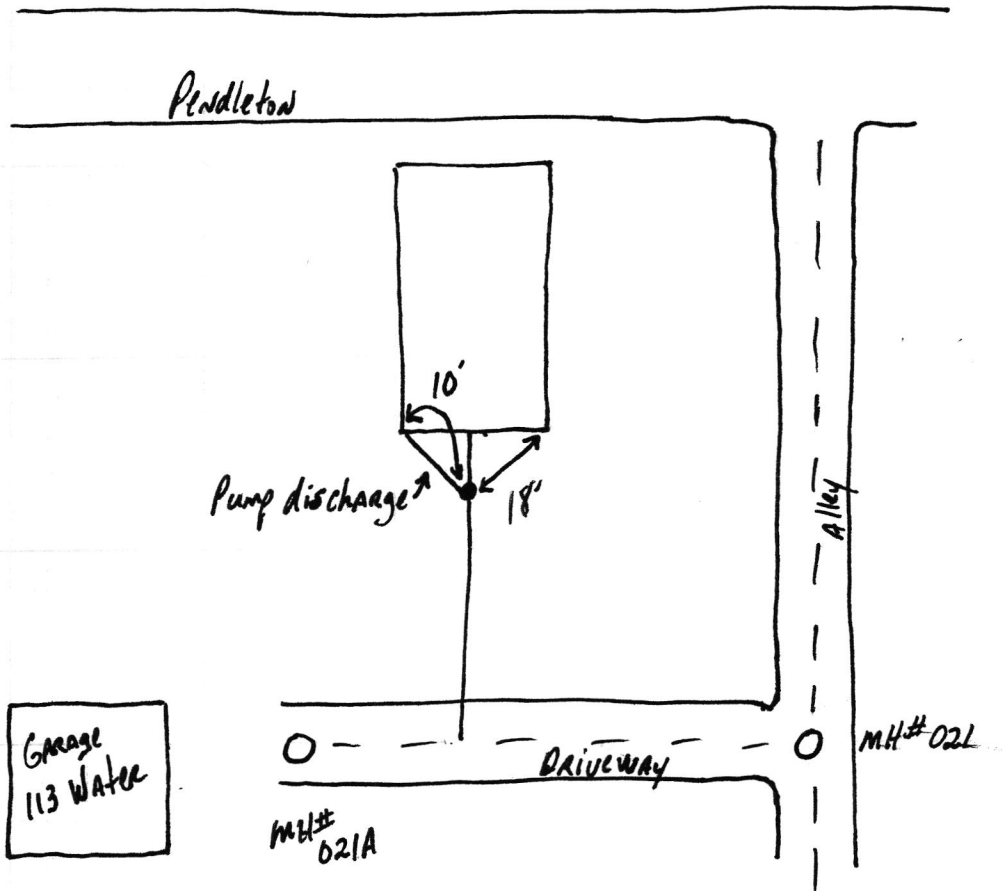

119 n Pendlehan

SRC Phase II

7.30.18

