

Side

PROJECT Phase II SHEET _____ OF _____


SUBJECT _____ DATE 7-12-18

JOB NO. 4447

BY AJ/AS

119 S. Caroline

N
↓

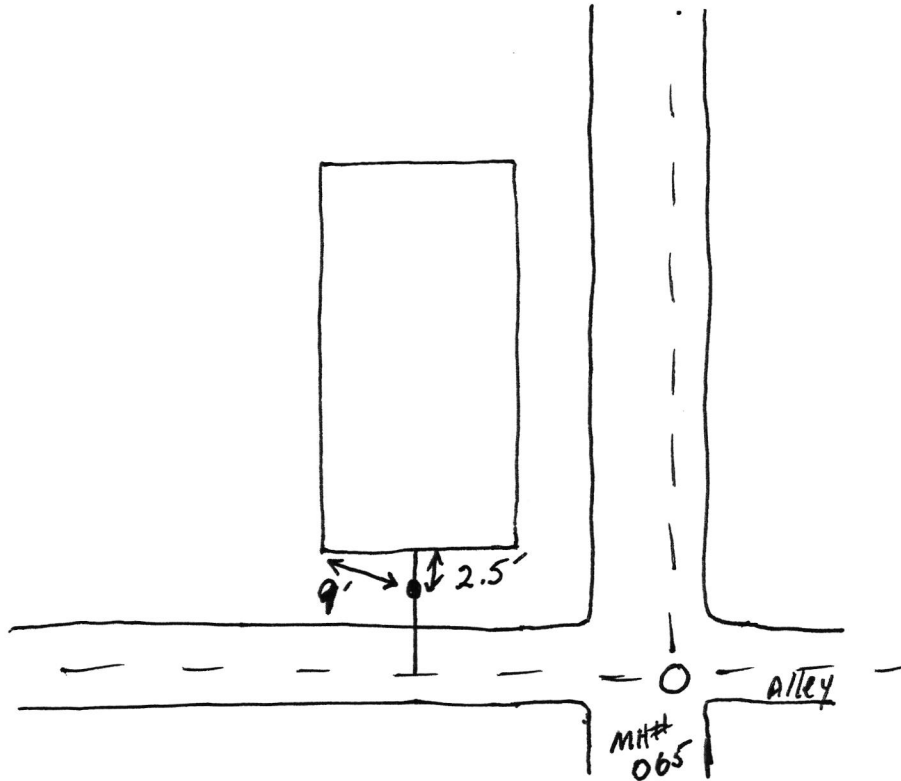

119 S Caroline

SAT Phase II

7.30.18

