

Gidw.

PROJECT

Phase II

SHEET

OF

SUBJECT

DATE

8-18

JOB NO.

4447


BY

Atlas

119 W. State

↑
N

State

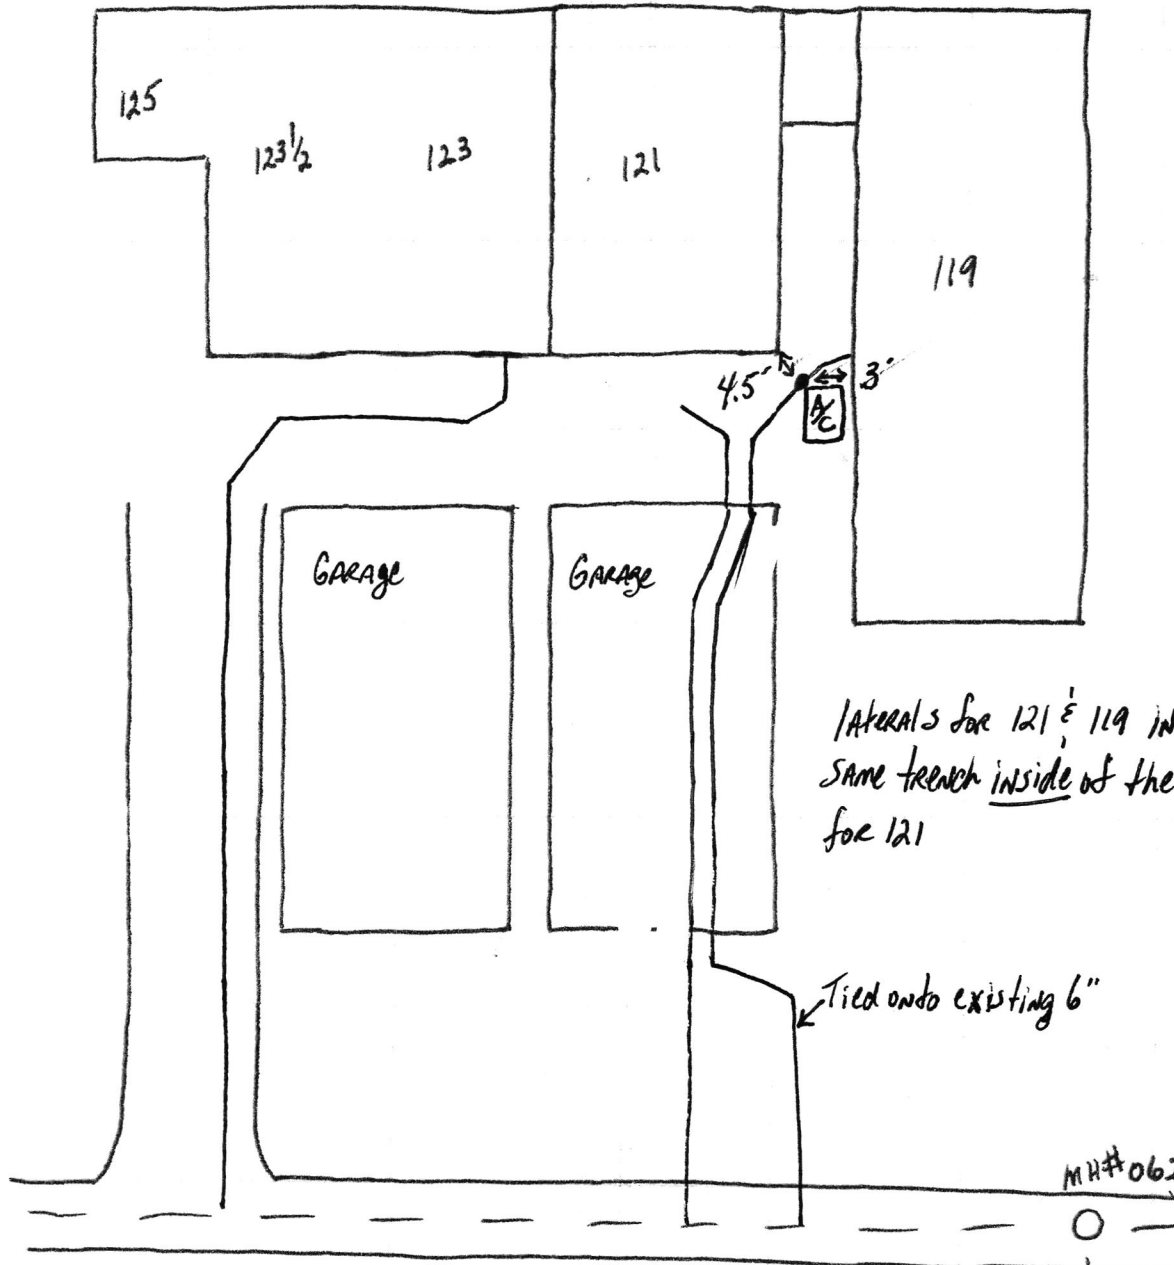



ONT mass IL

8.15.18

119 W State St

SRF Phase II

Tim McCreedy 2-19-19





