



FALL CREEK REGIONAL WASTE DISTRICT

Box 44, Pendleton, Indiana 46064

7-16170.00

job phone 778-7676
Attn: Scott

Nº 001769

APPLICATION FOR SEWER PERMIT

Permit No. _____ Date November 14, 1990
Permit Void 90 days from Date of Issuance
Owner Name McDonalds
Property Address I-69, S.R. 38
Lot # _____ P.O. Box _____
Town Pendleton, IN Zip Code 46064
Phone _____ Water Meter _____
\$ 2000.00 Tap on Fee Paid
\$ 25.00 Inspection fee paid

Application is hereby made for connection to the Fall Creek Regional Waste District Sewer System for the above listed property - Permit Type: Residential _____, Commercial X, Industrial _____, or Governmental/Institutional _____. User Information _____.

All workmanship and materials shall conform to the standards of the District Ordinance as described in Ordinance 84-2 and 84-3 as amended. Acceptance and approval must be made by the District inspector or his duly authorized representative before backfilling and final connection is made to the main sewer lines. Any violation of applicable regulations will cause all lines and appurtenances in violation to be removed and replaced at the owners expense.

The Fall Creek Regional Waste District is responsible for the inspection, approval of materials, and installation techniques only. All costs for materials and installation and any liabilities resulting from same is the sole responsibility of the property owner.

I have read and fully understand the above provisions and agree to comply by said provisions.

X Bill Hester

APPLICANT(S) SIGNATURE


INSPECTOR B

Date inspected 6-21-91 Approved ✓ Rejected _____

Reason for rejection _____

Date reinspected _____ Approved _____ Rejected _____

Notes:
Size Pipe 6 "
Type Pipe PVC
Basement Yes _____ No X
Sump Pump Yes _____ No X
Downspout to Ground Yes X No _____
Septic Tank Pumped & filled Yes _____ No X
Contractor JESCO
Special Conditions New Const

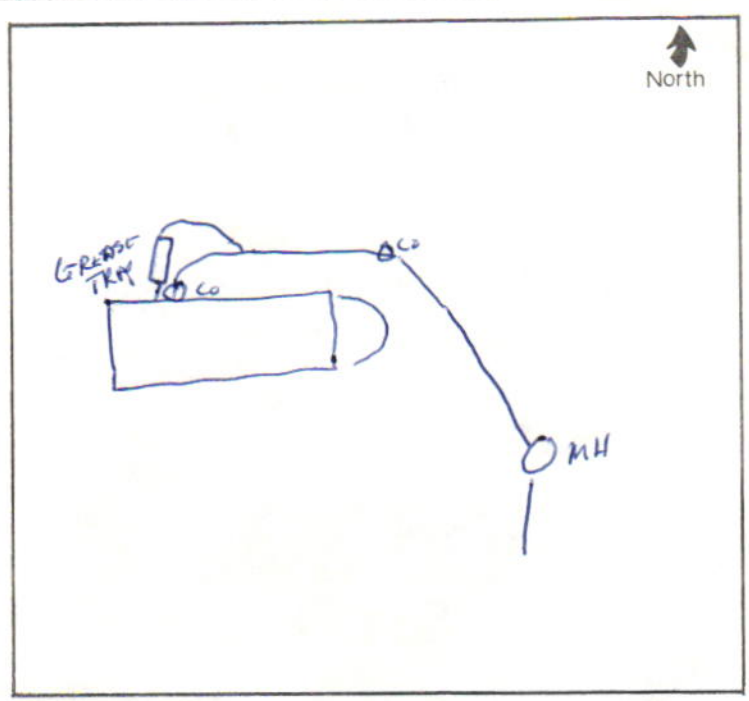

11-13-90
Dach

McDonalds I-69, SR 38

TAP-ON Fee

\$ 2,000.00 + Cost of Const (Developer)
+ 25 Insp / Admin

Commercial - Restaurant

30 SEAT + \$2,000.00

1500 GPD X \$0.50 = \$750 DISTRICT

Developer = \$1250

TOTAL \$ 3,000.00

WATER CONNECTION

USAGE \$10.45

+ \$1.66/1000 GAL