(120) 3-05334.00

FALL CREEK REGIONAL WASTE DISTRICT

9378 S 650 WEST, P.O. BOX 59, PENDLETON, IN 46064 765-778-7544

(122) 3-05336.00

al

d

AGREEMENT FOR SANITARY SEWER SERVICE

2219 1
This Agreement made and entered into this and day of Hugust, 200 /, between FALL CREEK
This Agreement made and entered into this 22 day of August, 200 /, between FALL CREEK REGIONAL WASTE DISTRICT ("District") and Michael Burkett ("Applicant") regarding the
provision of sanitary sewer service, and the assignment of capacity in, and connection to, the District's facilities for the
provision of sanitary sewer service, and the assignment of capacity in, and connection to, the District's facilities for the premises located at $120 + 122 $ Sendition Avenue
premises reduced in 100 100 100 100 100 100 100 100 100 10

NOW THEREFORE, the parties, in consideration of the mutual promises set out in this Agreement, the receipt and sufficiency of which is hereby acknowledged, agree as follows:

- 1. The Applicant agrees that all workmanship and materials shall conform the District's construction standards. District must accept and approve all work and connection is made to the sewer mains. Any violation of this provision will cause a to be removed and replaced at the Applicant's expense.
- The District shall have the right to enter upon the Applicant's preminspect, repair, or replace any equipment used in connection with the District's service.
- 3. The Applicant shall be responsible for all monthly user rates, capacity charges, and tap fees. The failure to pay any rate charge or fee may result in a lien against the property and/or the termination of service to the property, the cost of which will be borne by Applicant, including, but not limited to, all attorney's fees and collection costs.
- The District shall not be responsible for any damages as a result of any failure to supply service unless said damages are due to default, neglect or culpability on the part of the District.
- 5. If there is an available sanitary sewer within three hundred (300) feet of the property line, the property owner shall be required to connect to the District's sanitary sewer system.
- 6. The Applicant and District agree that the provision of sanitary sewer service touches and concerns the property and the terms of this Agreement bind the District and Applicant and their heirs, executors, administrators, personal representatives, successors, agents, attorneys, assigns, designees, and transferees.

The parties hereto have read and fully understand the above provisions and agree to comply with said provisions.

FALL CREEK REGIONAL WASTE DISTRICT
Signature

STATE OF INDIANA
SS:

COUNTY OF MADISON

SUBSCRIBED and sworn to before me this 2 day of Jugust, 200 |

My Commission Expires:

Printed Lebotah L. Wilson

Notary Public
Resident of Madison County

INSPECTOR Stare

DATE INSPECTED 9/4/6/ APPROVED REJECTED

NOTES:
SIZE PIPE 4"//2 TYPE PIPE 35/160

NOTES:
SIZE PIPE 4"//2 TYPE PIPE 35/160

NOTES:
SIZE PIPE 4"//2 TYPE PIPE 35/160

DOWNSPOUT TO GROUND YES NO

SEPTIC TANK PUMPED & FILLED YES NONA


CONTRACTOR PESSON

SPECIAL CONDITIONS

EXISTING HOME

NEW CONSTRUCTION

BASEMENT YES

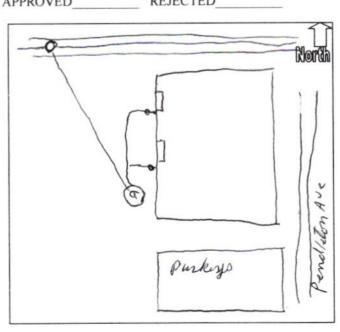

BURKETT BUILDERS, LLC

P.O. BOX 2364 ANDERSON, IN 46018 STAR FINANCIAL BANK 71-167-749

DATE

AMOUNT

Aug. 22, 2001 ***\$4,200.00

PAY

Four Thousand, Two Hundred Dollars and 00 Cents.

TO THE ORDER OF

Fall Creek Reg. Waste District 9378 S. 650 West Pendleton, IN 46064

"O17227" ::O74901672:

1

BURKETT BUILDERS, LLC

P.O. BOX 2364 ANDERSON, IN 46018 STAR FINANCIAL BANK 71-167-749

DATE

AMOUNT

Sep. 13, 2001 ***\$1,026.80

PAY

One Thousand, Twenty-six Dollars and 80 Cents.

TO THE ORDER OF

Fall Creek Reg. Waste District 9378 S. 650 West Pendleton, IN 46064

"O17259" 1:0749016721:

Lobert Burkett

BURKETT BUILDERS, LLC

17259

Check amount: ***\$1,026.80 Date: Sep. 13, 2001 Number: 017259

Check paid to: Fall Creek Reg. Waste District

Invoice: NONE-000002 09/12/01

Job: PENDLE 120-122 Pendleton Avenue

Sewer Tap \$ Capacity Fee \$1,026.80

Paid:

\$1,026.80