

26-00550.00

add order
on file
4124

FALL CREEK REGIONAL WASTE DISTRICT

9378 S 650 WEST, P.O. BOX 59, PENDLETON, IN 46064

765-778-7544

AGREEMENT FOR SANITARY SEWER SERVICE

This Agreement made and entered into this 15th day of March, 2001, between FALL CREEK REGIONAL WASTE DISTRICT ("District") and ERIC JOHNS ("Applicant") regarding the provision of sanitary sewer service, and the assignment of capacity in, and connection to, the District's facilities for the premises located at 120 Bess Boulevard.

NOW THEREFORE, the parties, in consideration of the mutual promises set out in this Agreement, the receipt and sufficiency of which is hereby acknowledged, agree as follows:

1. The Applicant agrees that all workmanship and materials shall conform to all District ordinances and the District's construction standards. District must accept and approve all work and materials before backfilling and final connection is made to the sewer mains. Any violation of this provision will cause all lines and appurtenances in violation to be removed and replaced at the Applicant's expense.
2. The District shall have the right to enter upon the Applicant's premises at all reasonable times to inspect, repair, or replace any equipment used in connection with the District's service or which has an impact on said service.
3. The Applicant shall be responsible for all monthly user rates, capacity charges, and tap fees. The failure to pay any rate charge or fee may result in a lien against the property and/or the termination of service to the property, the cost of which will be borne by Applicant, including, but not limited to, all attorney's fees and collection costs.
4. The District shall not be responsible for any damages as a result of any failure to supply service unless said damages are due to default, neglect or culpability on the part of the District.
5. If there is an available sanitary sewer within three hundred (300) feet of the property line, the property owner shall be required to connect to the District's sanitary sewer system.
6. The Applicant and District agree that the provision of sanitary sewer service touches and concerns the property and the terms of this Agreement bind the District and Applicant and their heirs, executors, administrators, personal representatives, successors, agents, attorneys, assigns, designees, and transferees.

The parties hereto have read and fully understand the above provisions and agree to comply with said provisions.

FALL CREEK REGIONAL WASTE DISTRICT

Signature

APPLICANT

Signature

STATE OF INDIANA)
) SS:
COUNTY OF MADISON)

SUBSCRIBED and sworn to before me this 15th day of March, 2001.

My Commission Expires:

2-20-2008

Signature

Printed

Notary Public

Resident of Madison County

INSPECTOR Bu DATE INSPECTED 4.7.1 APPROVED ✓ REJECTED _____

REASON FOR REJECTION _____

DATE REINSPECTED _____ APPROVED _____ REJECTED _____


NOTES:

SIZE PIPE 6 TYPE PIPE 26BASEMENT YES _____ NO XSUMP PUMP YES _____ NO XDOWNSPOUT TO GROUND YES X NO _____SEPTIC TANK PUMPED & FILLED YES Later NO _____CONTRACTOR Oles Const + Self

SPECIAL CONDITIONS _____

EXISTING HOME X

NEW CONSTRUCTION _____

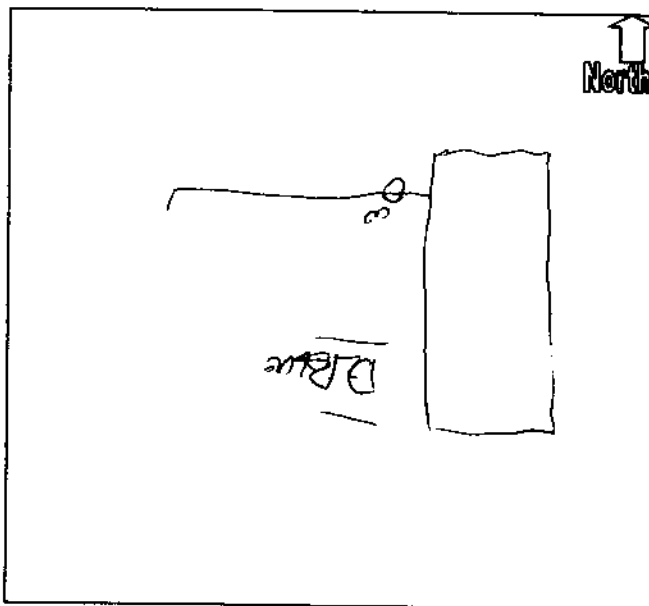

9378 S 650 W
Pendleton, IN 46064
765-778-7544 fax 765-778-7545

Customer

Name ERIC JOHNS
Address 120 BESS BOULEVARD
City PENDLETON State IN
Phone

Date 4/10/01
Order No. _____
Rep _____
FOB _____

	SubTotal	\$50.00
Shipping & Handling		\$0.00
Taxes	State	
	TOTAL	\$50.00

☐ Cash
☒ Check
☐ Credit Card

Name _____
CC # _____
Expires _____

Office Use Only

Insert Farewell Statement Here