

Gidw.


PROJECT Phase II SHEET _____ OF _____

SUBJECT _____ DATE 4-22-18

JOB NO. 4447

BY Atlas

120 S. West

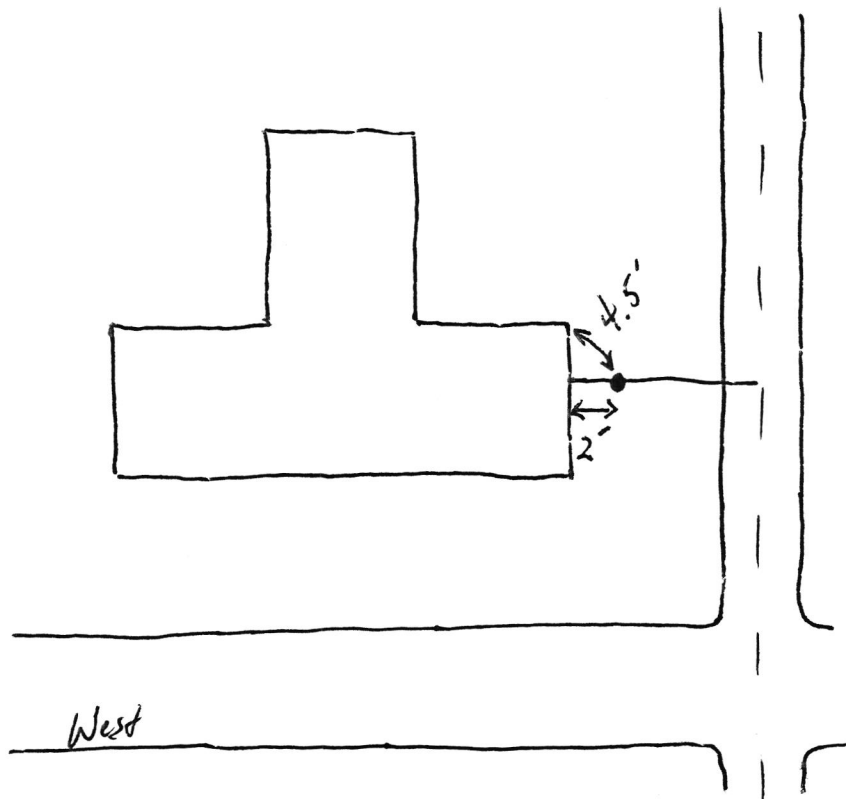

120 S West

SHP
Phase II

5.3.18

