



FALL CREEK REGIONAL WASTE DISTRICT

9378 S. 650 West PO Box 59
Pendleton, IN 46064-0059 778-7544

add order
on file

Bernard Kennedy
22-03542.00

APPLICATION FOR SEWER PERMIT

Nº 2058

Date

4/19/94

Permit Void 90 days from Date of Issuance

Owner Name

Virginia McClain Mustin Builders

Property Address

1216 Pendle Hill Ave.

Lot #

3 - Pendle Hill

P.O. Box

Town

Pendleton

IN

Zip Code

46064

Phone

City Water

Well

✓

\$ 100.00

Tap on Fee Paid

\$ 25.00

Inspection fee paid

Application is hereby made for connection to the Fall Creek Regional Waste District Sewer System for the above listed property - Permit Type: Residential ☒, Commercial ☐, Industrial ☐, or Governmental/Institutional ☐. User Information

All workmanship and materials shall conform to the standards of the District Ordinance as described in Ordinance 84-2 and 84-3 as amended. Acceptance and approval must be made by the District inspector or his duly authorized representative before backfilling and final connection is made to the main sewer lines. Any violation of applicable regulations will cause all lines and appurtenances in violation to be removed and replaced at the owners expense.

The Fall Creek Regional Waste District is responsible for the inspection, approval of materials, and installation techniques only. All costs for materials and installation and any liabilities resulting from same is the sole responsibility of the property owner.

I have read and fully understand the above provisions and agree to comply by said provisions.

Virginia L. McClain

APPLICANT(S) SIGNATURE

INSPECTOR

Tim

Date inspected

5/17/95

Approved

Rejected

Reason for rejection

Date reinspected

Approved

Rejected

Notes:

Size Pipe

4"

Type Pipe

Sch. 40

Basement Yes

No

Sump Pump Yes

No

Downspout to Ground Yes

No

Septic Tank Pumped & filled Yes

No


Contractor

Mustin

Special Conditions

Existing Home

New Construction

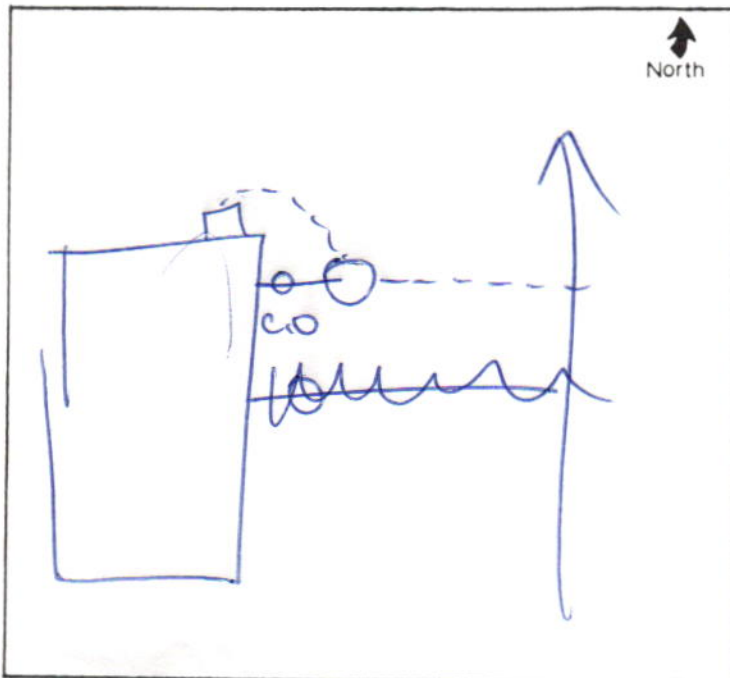

~~Letter~~ Mustin Builders
644-8502 Lawrence
bought lots off of Johnson
Virginia McLean

12, 1219 Pendle Hill Ave
3, 1216 Pendle Hill Ave

make copies & send to:

Mustin
810 Central Ave.
Anderson 46012