



FALL CREEK REGIONAL WASTE DISTRICT

9378 S. 650 West PO Box 59
Pendleton, IN 46064-0059 778-7544

add order
on file

22-03543.00

Dary Erskine

Nº 2060

APPLICATION FOR SEWER PERMIT

Date 4/19/94

Permit Void 90 days from Date of Issuance

Owner Name Virginia McClair Mustin Builders

Property Address 1219 Pendle Hill Ave.

Lot # 12 - Pendle Hill P.O. Box _____

Town Pendleton, IN Zip Code 46064

Phone _____ City Water _____ Well ☒

\$ 700.00 Tap on Fee Paid

\$ 25.00 Inspection fee paid

Application is hereby made for connection to the Fall Creek Regional Waste District Sewer System for the above listed property - Permit Type: Residential ☒, Commercial _____, Industrial _____, or Governmental/Institutional _____. User Information _____.

All workmanship and materials shall conform to the standards of the District Ordinance as described in Ordinance 84-2 and 84-3 as amended. Acceptance and approval must be made by the District inspector or his duly authorized representative before backfilling and final connection is made to the main sewer lines. Any violation of applicable regulations will cause all lines and appurtenances in violation to be removed and replaced at the owners expense.

The Fall Creek Regional Waste District is responsible for the inspection, approval of materials, and installation techniques only. All costs for materials and installation and any liabilities resulting from same is the sole responsibility of the property owner.

I have read and fully understand the above provisions and agree to comply by said provisions.

Virginia L. McClair
APPLICANT(S) SIGNATURE

INSPECTOR Dart

Date inspected 12/14/94 Approved ☒ Rejected _____

Reason for rejection _____

Date reinspected _____ Approved _____ Rejected _____

Notes:

Size Pipe 1 1/4 F.M. 4"

Type Pipe PVC

Basement Yes _____ No _____

Sump Pump Yes _____ No _____

Downspout to Ground Yes ☒ No _____


Septic Tank Pumped & filled Yes NA

Contractor MUSTIN

Special Conditions _____

Existing Home _____

New Construction ☒

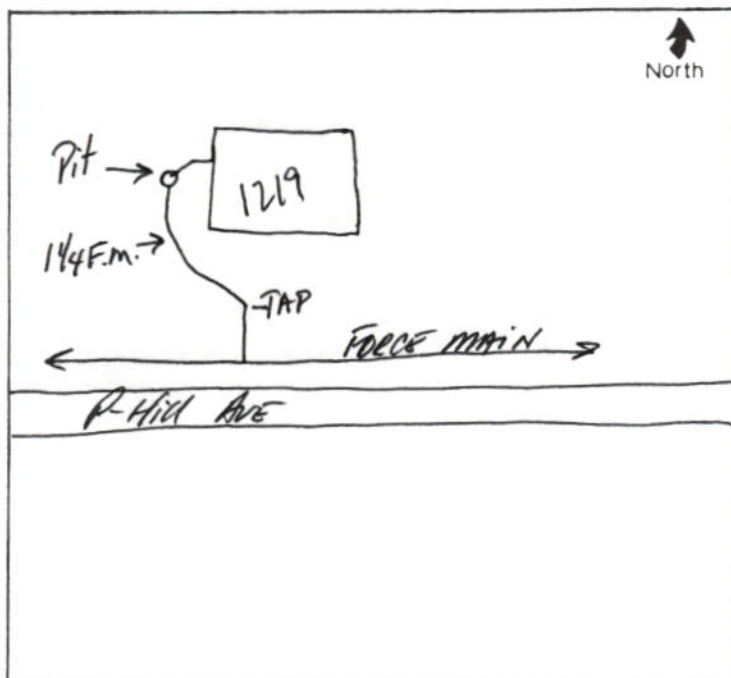

~~Noted~~ Mustin Builders
644-8502 Lawrence
bought lots off of Johnson
Virginia McLain

12, 1219 Pendle Hill Ave
3, 1216 Pendle Hill Ave

make copies & send to:

Mustin
810 Central Ave.
Anderson 46012