

Gidw.

PROJECT Phase II SHEET _____ OF _____


SUBJECT _____ DATE 6-18-18

JOB NO. 4447

BY Atlas

↑
N

121 E. Indiana

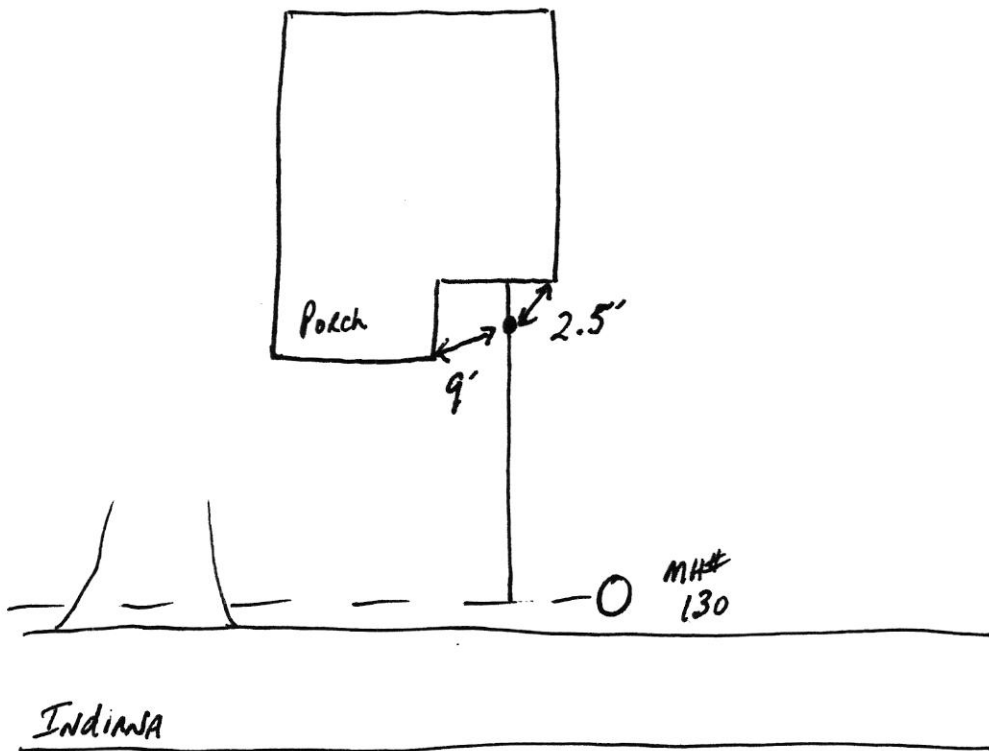

1a1 Indiana

SAP Phase II

6.19.18

