



PROJECT Phase II


SHEET _____ OF _____
1-18-18

SUBJECT _____

DATE 1-18-17

JOB NO. 4447

BY AH/As

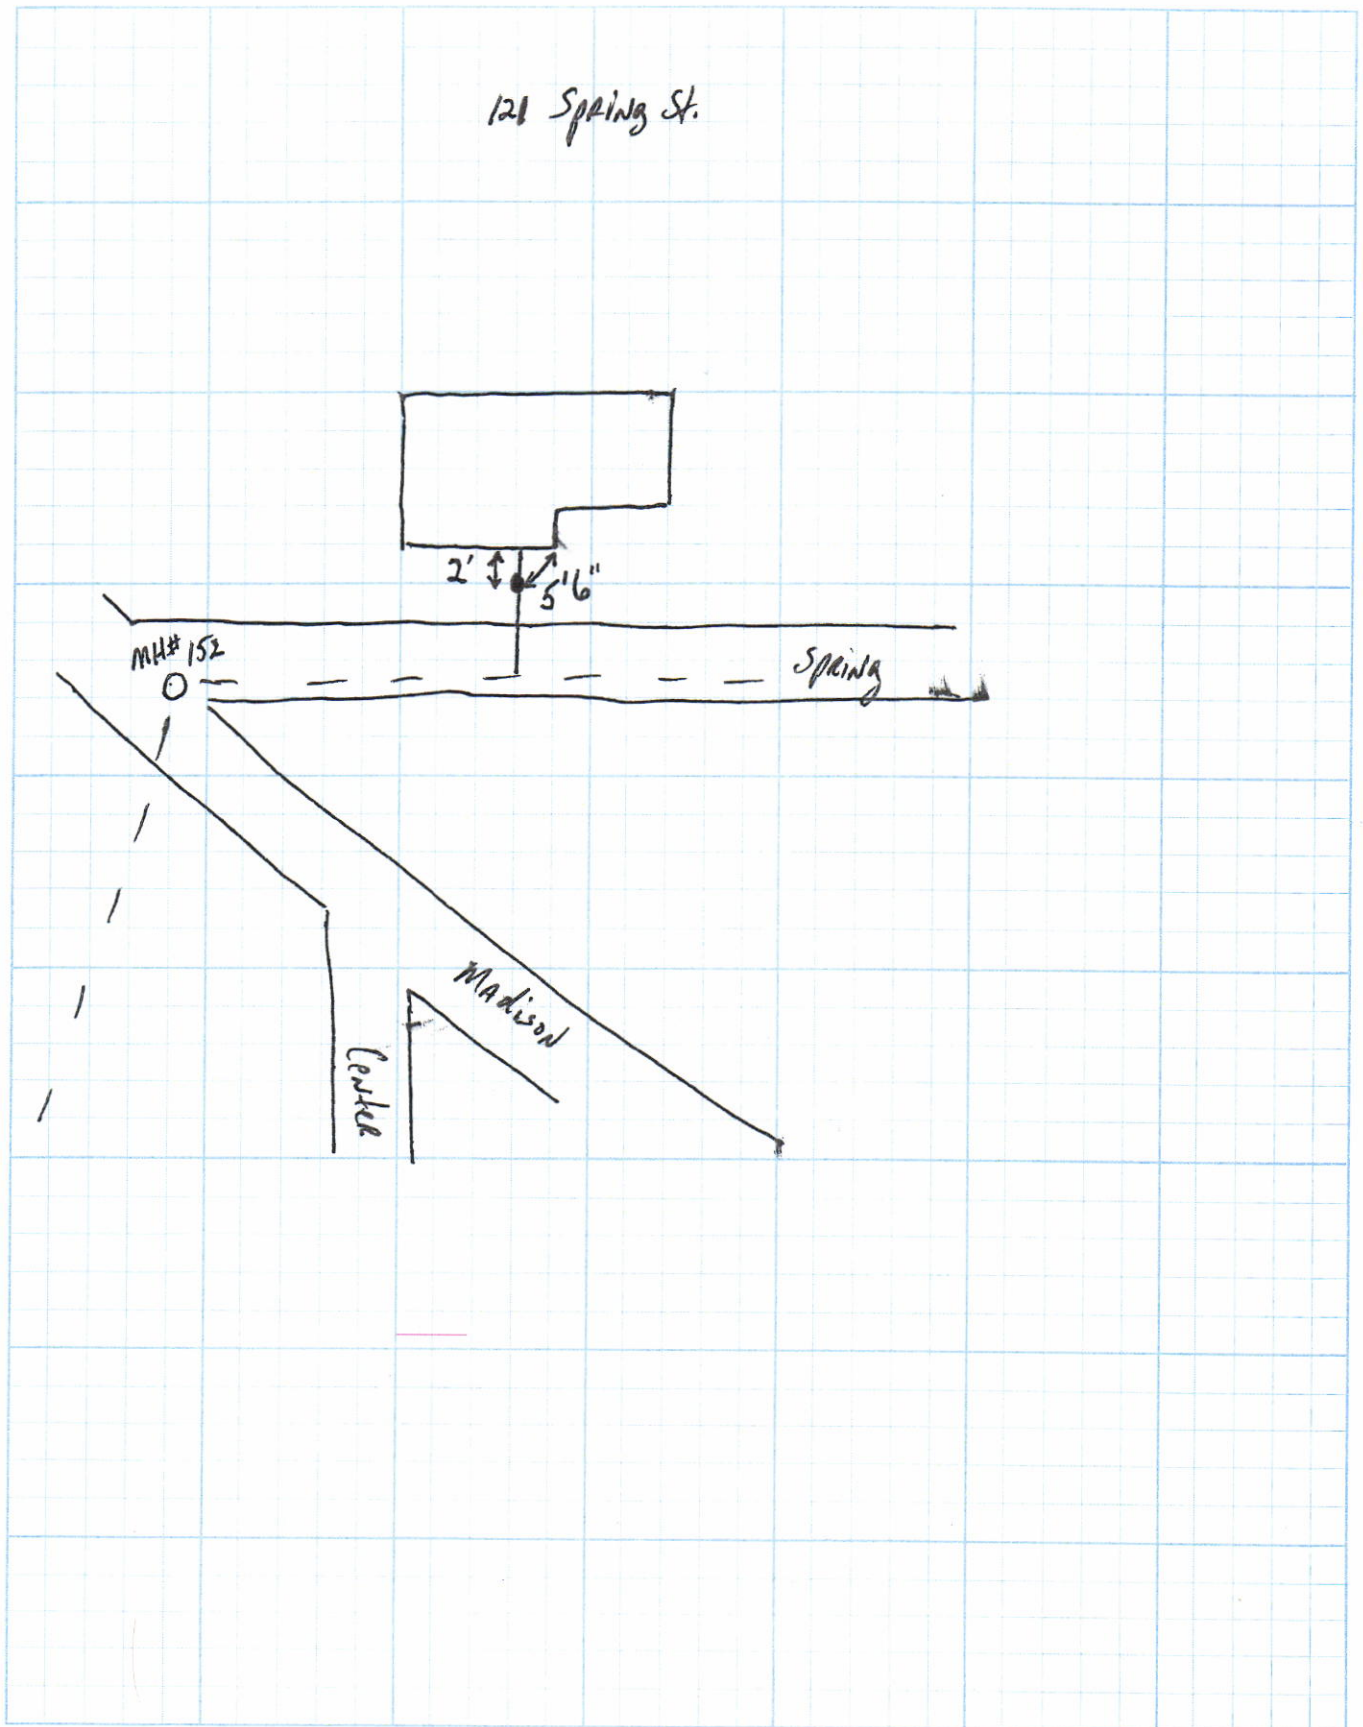

121 Spring ST

SRP Phase II

1-18-18

