

add order
on file

FALL CREEK REGIONAL WASTE DISTRICT

9378 S. 650 West PO Box 59
Pendleton, IN 46064-0059 778-7544

22-03544.00

APPLICATION FOR SEWER PERMIT

No 2071

Date 4/20/94

Permit Void 90 days from Date of Issuance

Owner Name

Mark ~~fradison~~ Gradison Randy Greenwell

Property Address

1220 Pendle Hill Ave.

Lot #

4- Pendle Hill

P.O. Box

Town

Pendleton

,

IN

Zip Code

46064

Phone

City Water

Well

☒

\$ 1700.00

Tap on Fee Paid

\$

Inspection fee paid

Application is hereby made for connection to the Fall Creek Regional Waste District Sewer System for the above listed property - Permit Type: Residential ☒, Commercial ☐, Industrial ☐, or Governmental/Institutional ☐. User Information

All workmanship and materials shall conform to the standards of the District Ordinance as described in Ordinance 84-2 and 84-3 as amended. Acceptance and approval must be made by the District inspector or his duly authorized representative before backfilling and final connection is made to the main sewer lines. Any violation of applicable regulations will cause all lines and appurtenances in violation to be removed and replaced at the owners expense.

The Fall Creek Regional Waste District is responsible for the inspection, approval of materials, and installation techniques only. All costs for materials and installation and any liabilities resulting from same is the sole responsibility of the property owner.

I have read and fully understand the above provisions and agree to comply by said provisions.

APPLICANT(S) SIGNATURE

INSPECTOR Tim

Date inspected 10/29/94

Approved ☒

Rejected ☐

Reason for rejection

Date reinspected

Approved

Rejected

Notes:

Size Pipe

4"

Type Pipe

SDR 35

Basement Yes

No ☒

Sump Pump Yes

No ☒

Downspout to Ground Yes ☒

No

Septic Tank Pumped & filled Yes

No


Contractor

Special Conditions

Control Panel

Existing Home

New Construction ☒

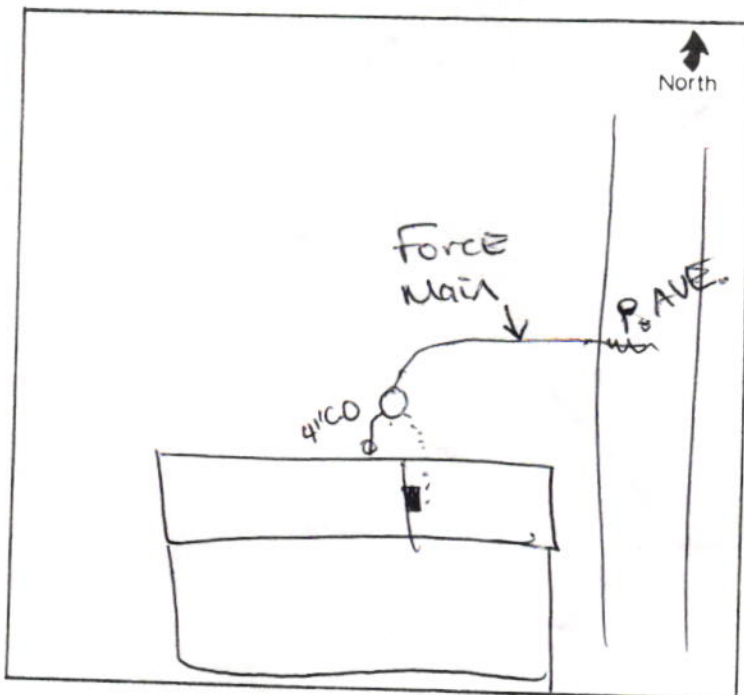

EDEN HOMES

REMITTANCE ADVICE

DETACH BEFORE DEPOSITING

VENDOR NO.

VENDOR NAME

0001109

TRANSAGTION DATE	REFERENCE	GROSS AMOUNT	DEDUCTION	NET AMOUNT
4/19/94	Tap Fee - Lot 4, Pendle Hills, Section 4			\$700.00
CHECK DATE	CHECK NO.	TOTAL GROSS	TOTAL DEDUCTIONS	CHECK AMOUNT