


Gidw.

PROJECT Phase II SHEET _____ OF _____
SUBJECT _____ DATE 7-23-18
JOB NO. 4447
BY Atlas

122 N. Main

← N

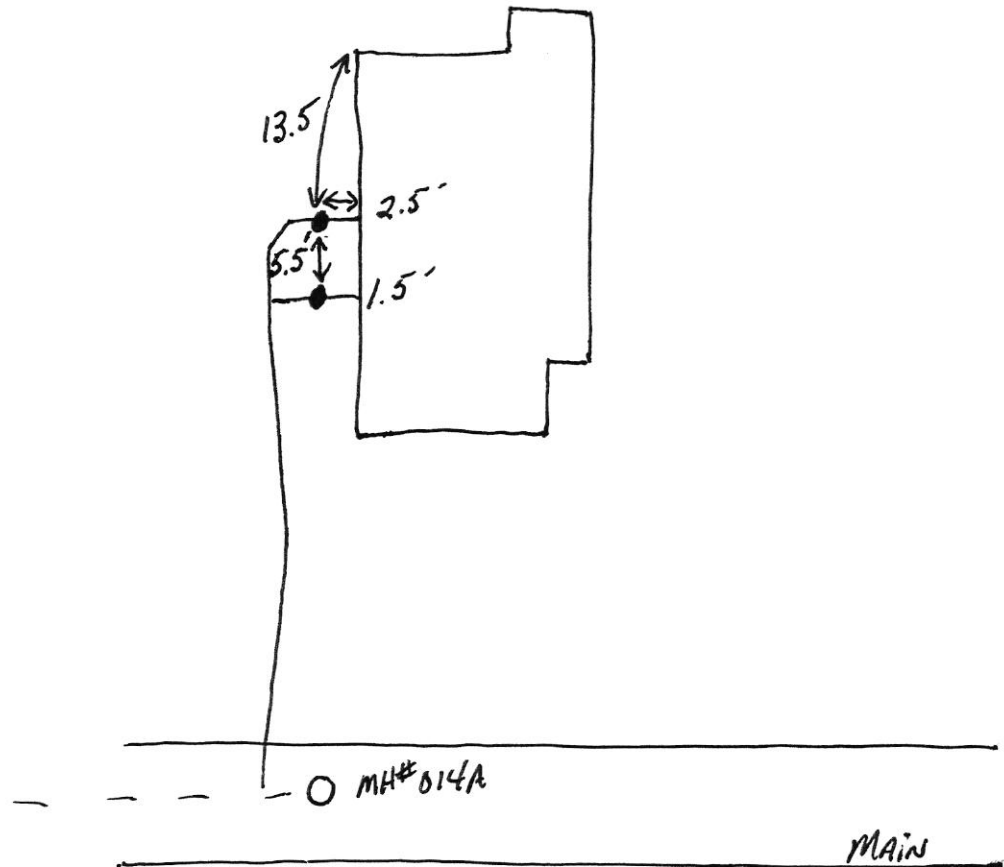


10a N Main

SRC Phase II

7.30.18



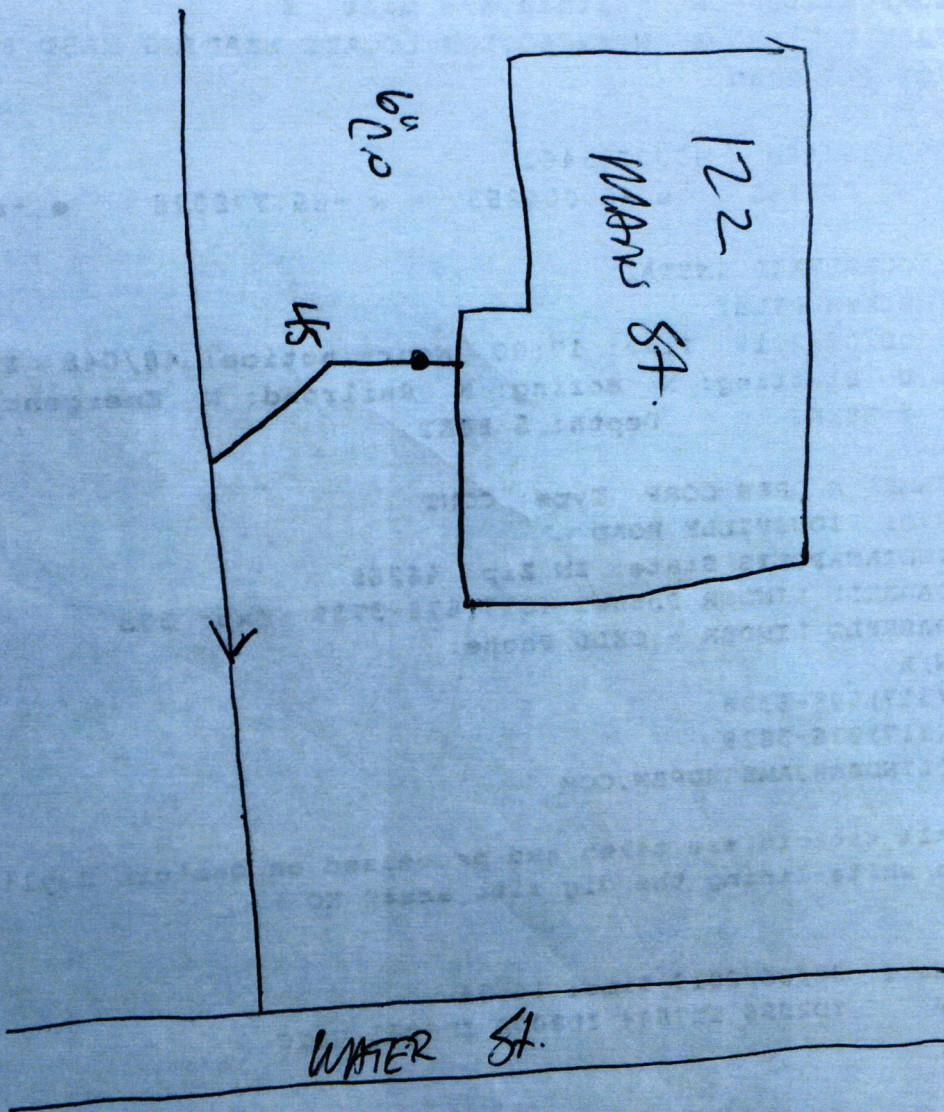

8-7-19
L.A. REHAR

122 main ST Rehab

Don Moore 8.7.19

