



FALL CREEK REGIONAL WASTE DISTRICT

Box 44, Pendleton, Indiana 46064

1-0002875.00

Nº 000043

APPLICATION FOR SEWER PERMIT

Permit No. _____ Date 7-29-85
Permit Void 90 days from Date of Issuance
Owner Name Garnet A. Owen
Property Address 122 S. Houston
Lot # _____ P.O. Box P.O. Box 345
Town Ingers, IN Zip Code 46048
Phone 485-5830 Water Meter Ingers
\$ 150.00 Tap on Fee Paid
\$ 25.00 Inspection fee paid

Application is hereby made for connection to the Fall Creek Regional Waste District Sewer System for the above listed property - Permit Type: Residential ☒, Commercial _____, Industrial _____, or Governmental/Institutional _____. User Information _____.

All workmanship and materials shall conform to the standards of the District Ordinance as described in Ordinance 84-2 and 84-3 as amended. Acceptance and approval must be made by the District inspector or his duly authorized representative before backfilling and final connection is made to the main sewer lines. Any violation of applicable regulations will cause all lines and appurtenances in violation to be removed and replaced at the owners expense.

The Fall Creek Regional Waste District is responsible for the inspection, approval of materials, and installation techniques only. All costs for materials and installation and any liabilities resulting from same is the sole responsibility of the property owner.

I have read and fully understand the above provisions and agree to comply by said provisions.


Garnet A. Owen
APPLICANT(S) SIGNATURE

INSPECTOR [Signature]

Date inspected 10-16-85 Approved [Signature] Rejected _____
Reason for rejection _____

Date reinspected _____ Approved _____ Rejected _____

Notes:
Size Pipe 6"
Type Pipe PVC
Basement Yes _____ No X
Sump Pump Yes _____ No X
Downspout to Ground Yes X No _____
Septic Tank Pumped & filled Yes _____ No X
Contractor BILL PASSMORE
Special Conditions INSIDE PLUMBING TO BE COMPLETED SOON

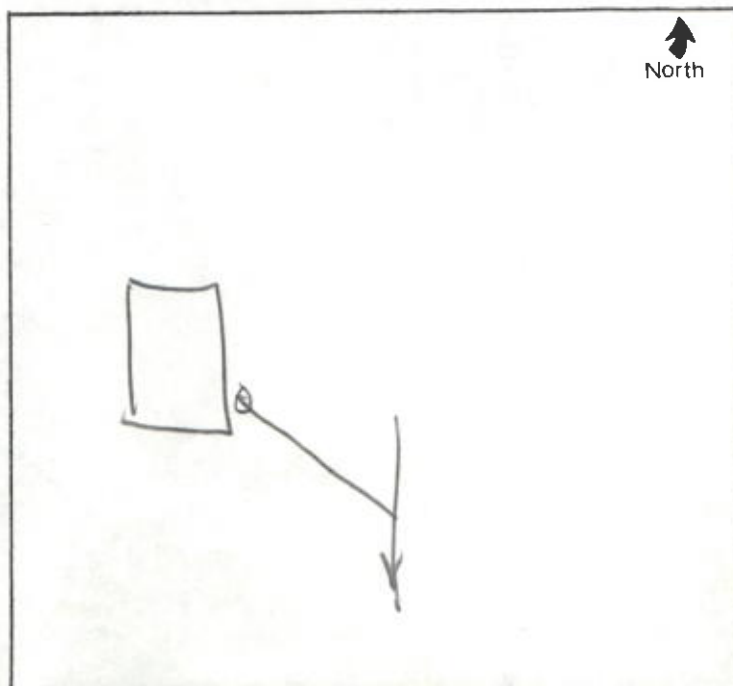



No. 000043

~~100-100~~

James A. Turner
121 D. Johnston
400 342
400 18
James

James
402-2830
4-22-72


120.00
22.00

The Fall Creek Regional Waste District is a public utility district created by the voters of the region in 1964. The district is responsible for the collection, transportation, and disposal of solid waste within the region. The district is currently operating a transfer station and a landfill. The district is also responsible for the construction and maintenance of the waste management facilities. The district is currently seeking to raise funds to expand its facilities and improve its services. The district is currently operating a transfer station and a landfill. The district is also responsible for the construction and maintenance of the waste management facilities. The district is currently seeking to raise funds to expand its facilities and improve its services.

James A. Turner

of

100-100

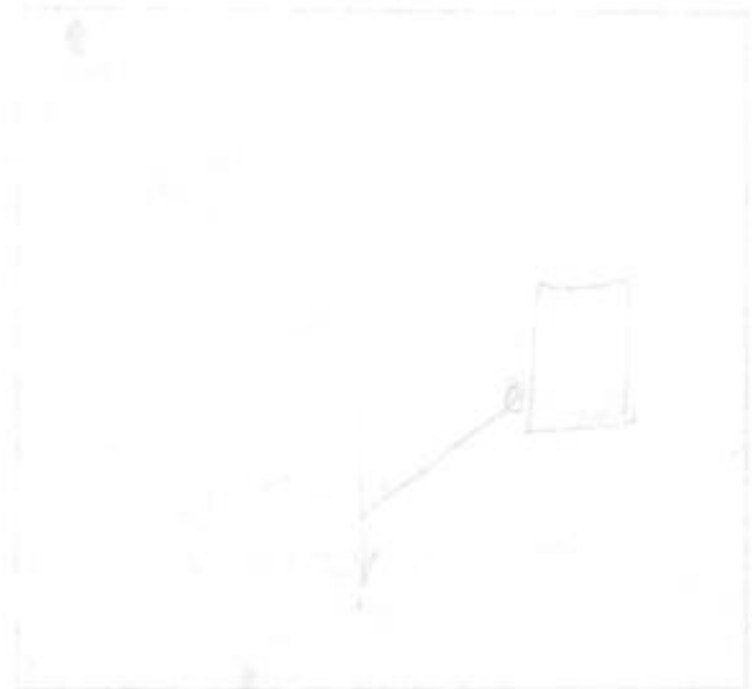

James A. Turner
121 D. Johnston
400 342
400 18
James

122 S Huston ST

Repair

Tim Melurdy

09/2023



122 S Huston St Repair

Tim McCurdy

09/13/2023



122 S Huston ST

Repair

Tim McCurdy 09/2023