


Gidw.

PROJECT Phase SHEET _____ OF _____
SUBJECT _____ DATE 4-18-18
JOB NO. 4447
BY Atlas

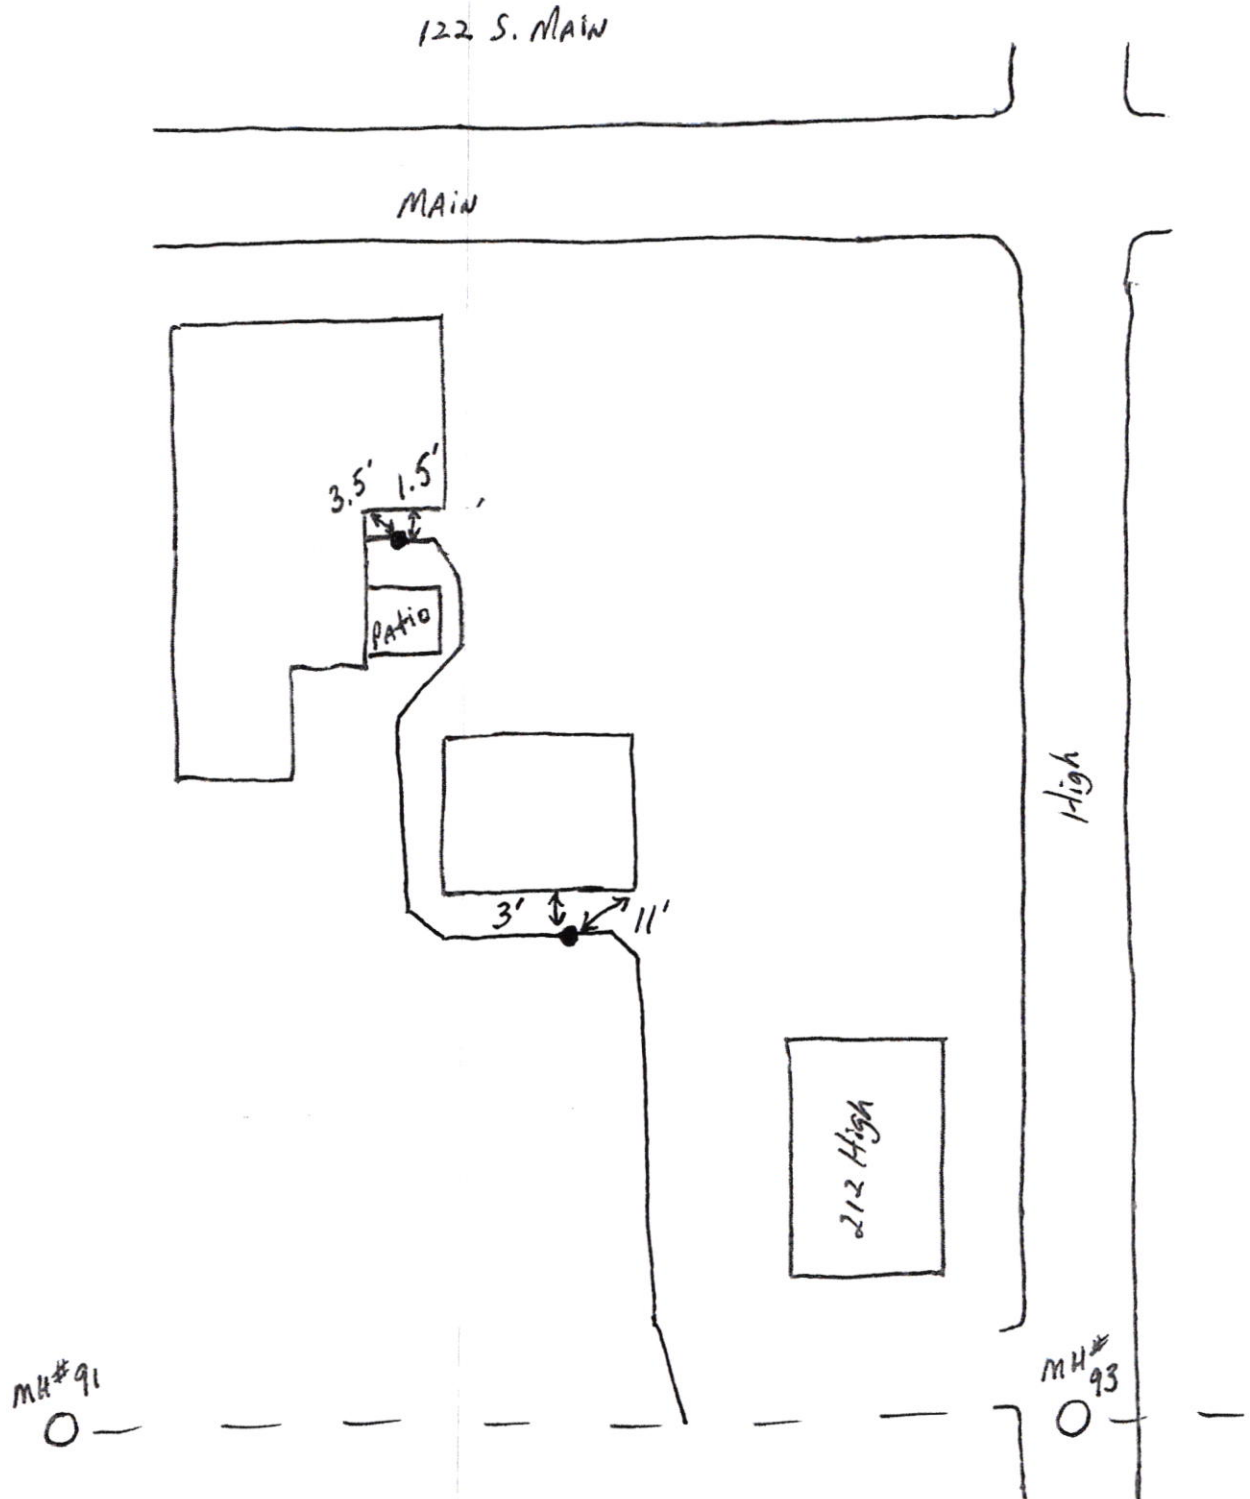

122 S main

SAP
Phase II

4.20.18



12a S main

SRF
Phase II

4.20.18

