


GLW

PROJECT Phase II SHEET _____ OF _____

SUBJECT _____ DATE 8-18

JOB NO. 4447

BY Atlas

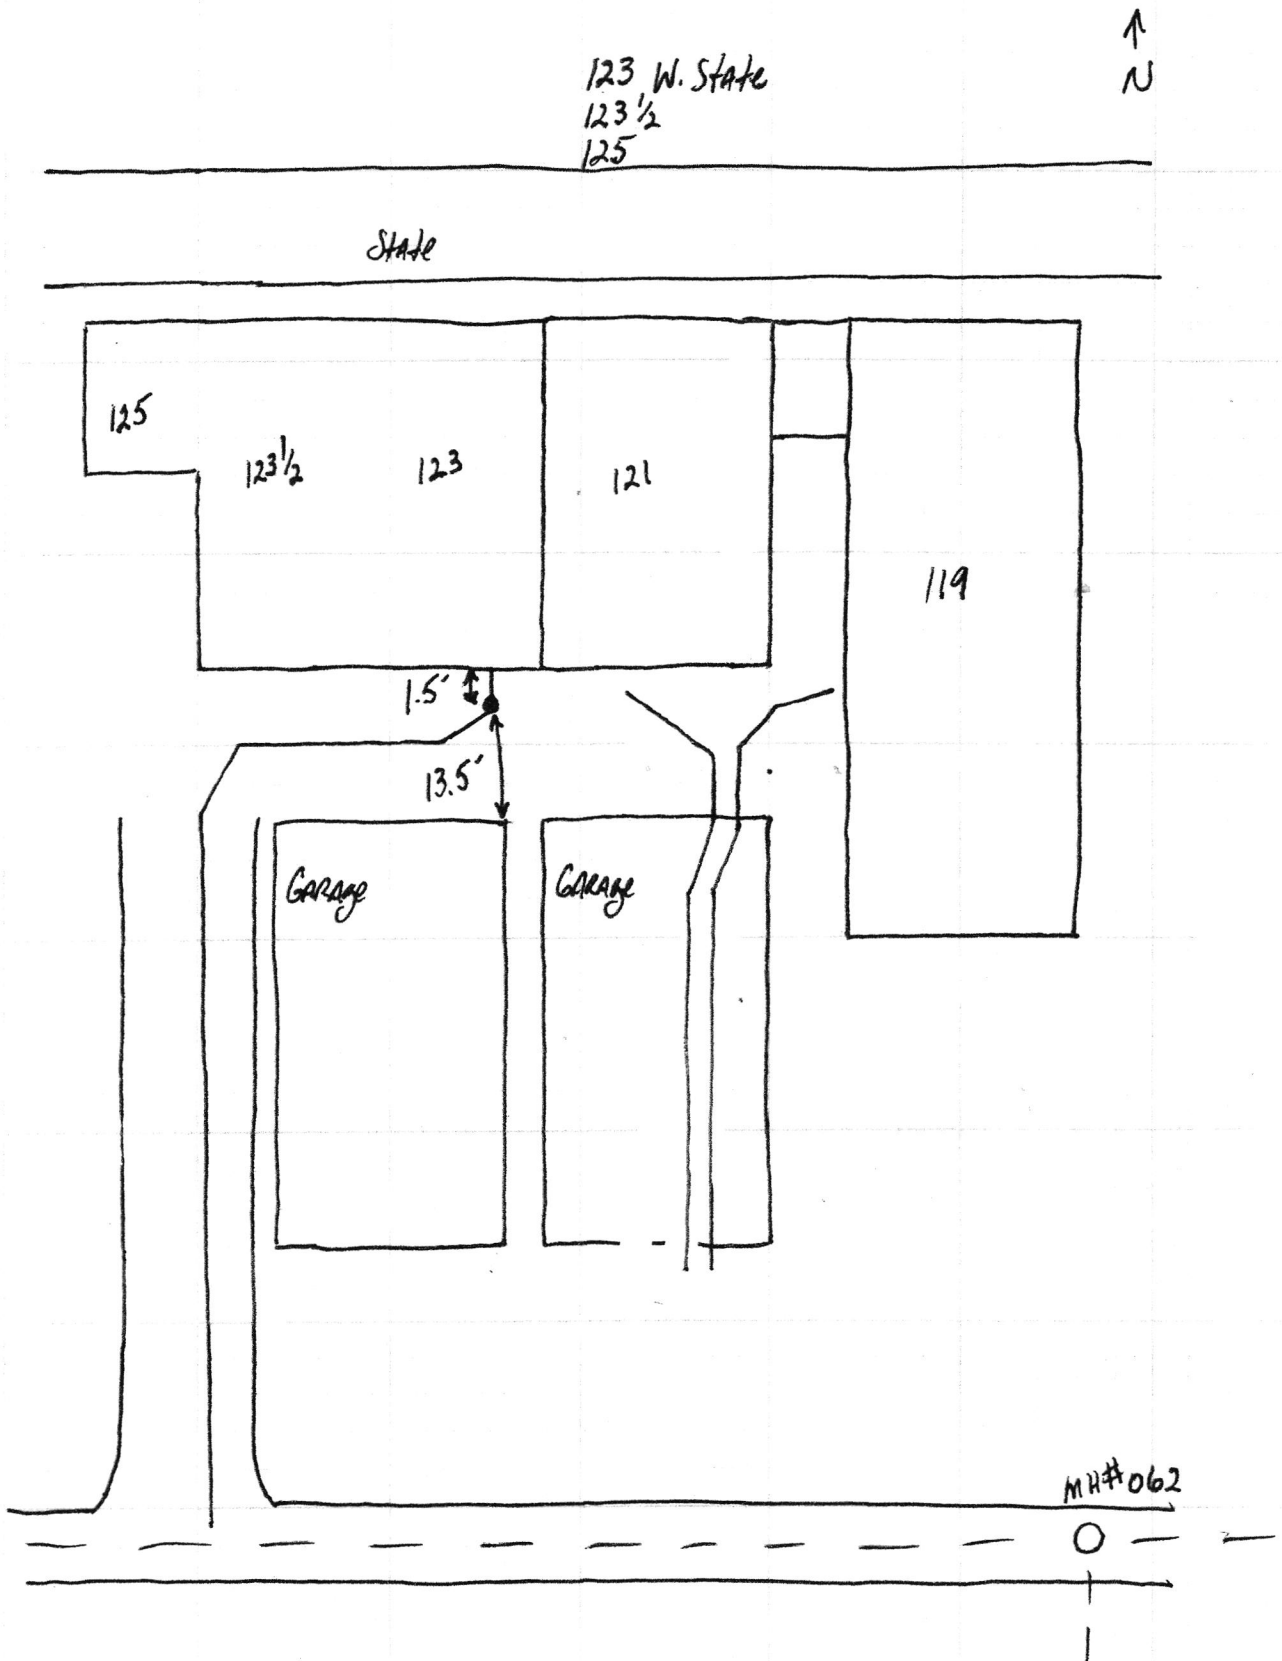



in
to start

Sgt Phase II

8.15.18



BOWMAN

CONSTRUCTION
Since 1895

SAFETY STARTS
WITH ME

