

Gidw.


PROJECT Phase II SHEET _____ OF _____

SUBJECT _____ DATE 5-1-18

JOB NO 4447

BY Atlas

123 Franklin

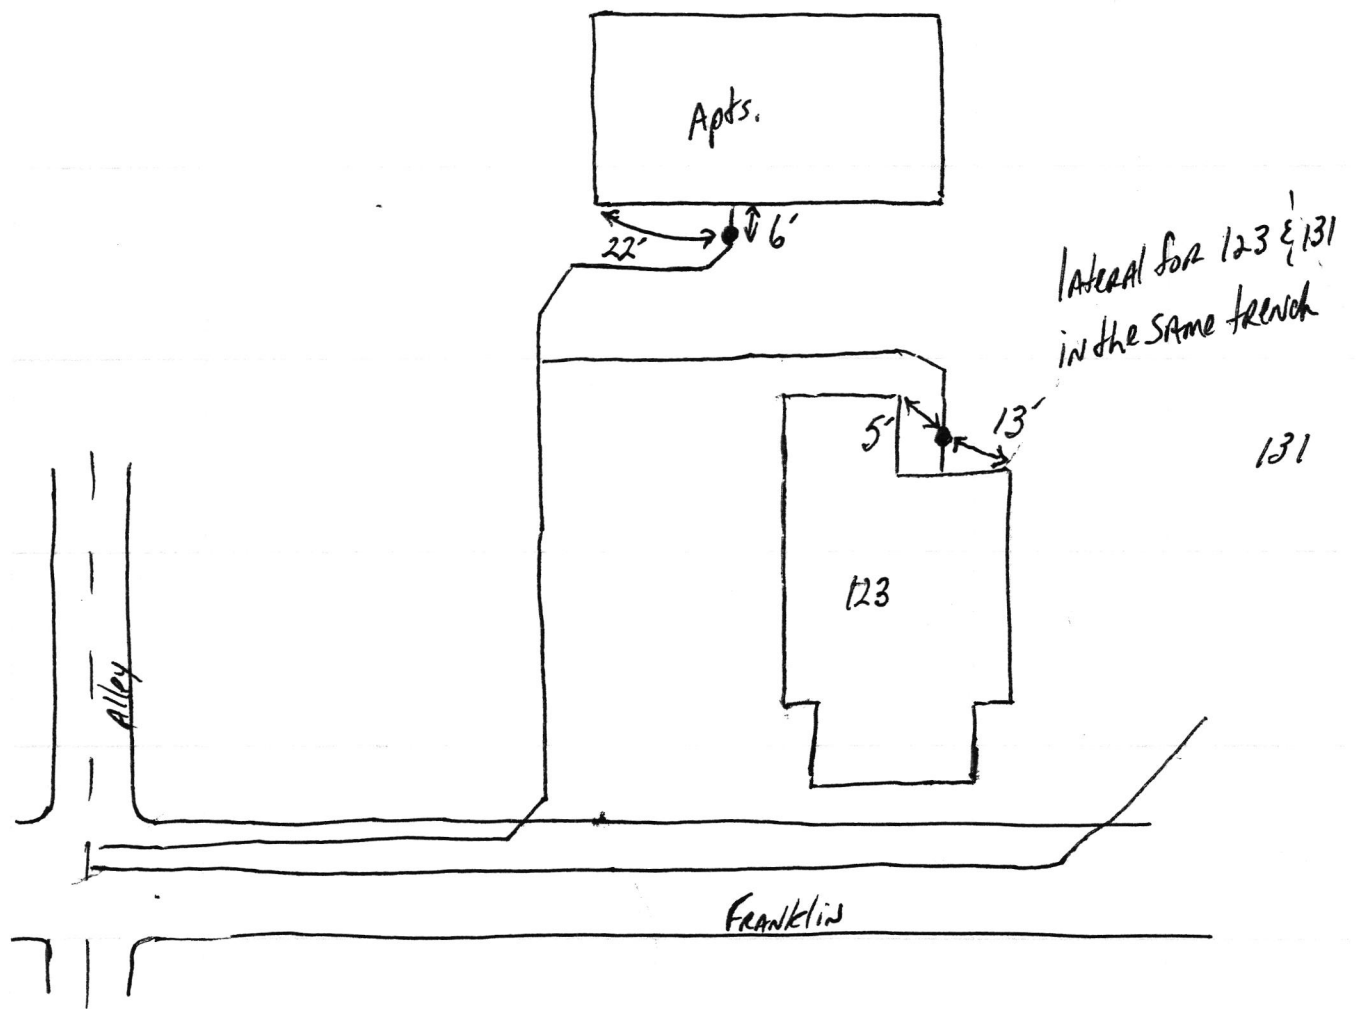

123 Franklin

SHF Phase II

5.14.18



123 Franklin

SRP
Phase II

5-3-18

