


Gidw.

PROJECT Phase II SHEET _____ OF _____
SUBJECT _____ DATE 5-22-18
JOB NO. 4447
BY Atlas

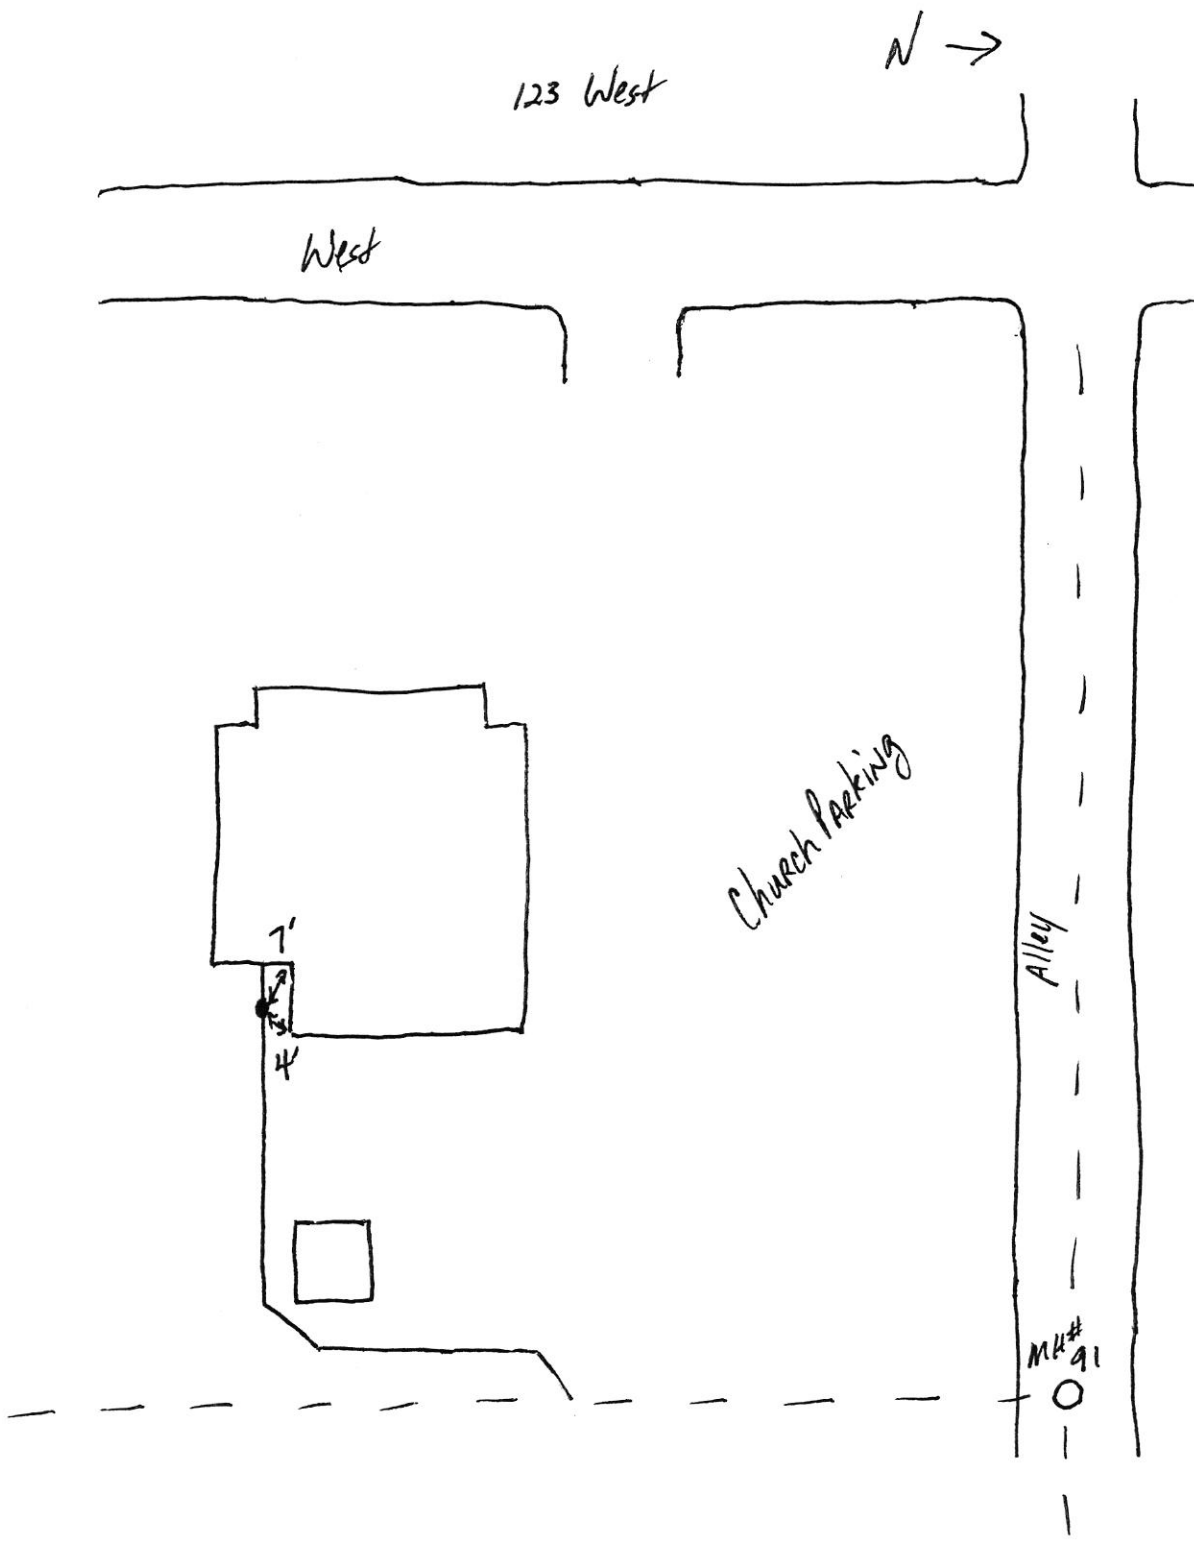

1a3 S West

SRF Phase II

5.22.18

