

Gidw.



PROJECT Phase II SHEET _____ OF _____

SUBJECT _____ DATE 8-6-18

JOB NO. 4447

BY Atlas

123 W. Water

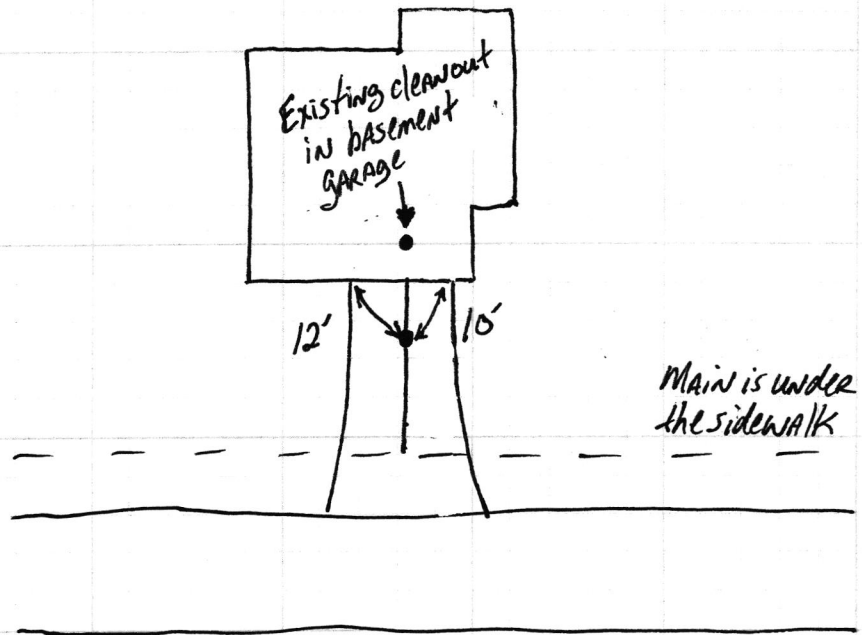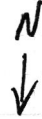



ONT Phase II

8.15.18