


Gidw.

PROJECT Phase II SHEET _____ OF _____
SUBJECT _____ DATE 6-15-18
JOB NO 4447
BY Atlas

124/126 E. Indiana

N
↓

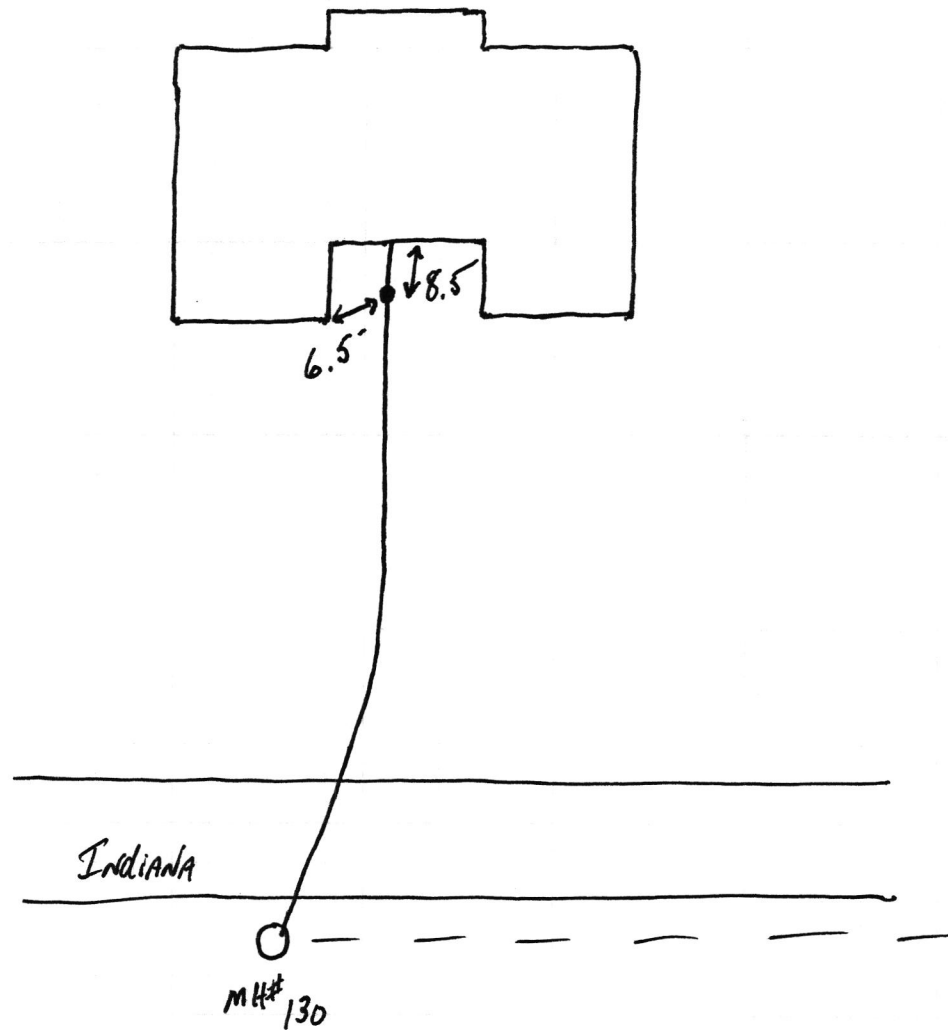

124-126 Indiana

SRF Phase II

6.19.18

