


Gidw.

PROJECT Phase II SHEET _____ OF _____

SUBJECT _____ DATE 7-24-18

JOB NO 4447

BY Atlas

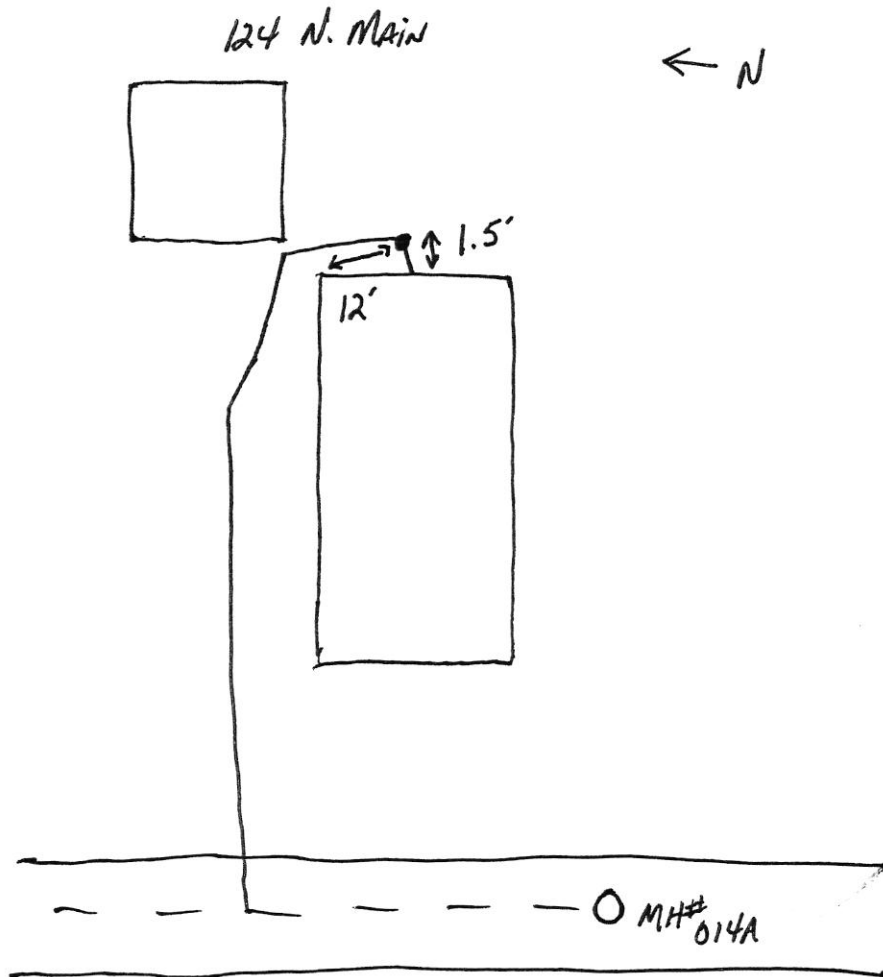

1st N Main

SFC Phase II

7.30.18

