

Gidw.

PROJECT Phase II SHEET _____ OF _____


SUBJECT _____ DATE 8-1-18

JOB NO. 4447

BY Atlas

125 N. Pendleton

← N

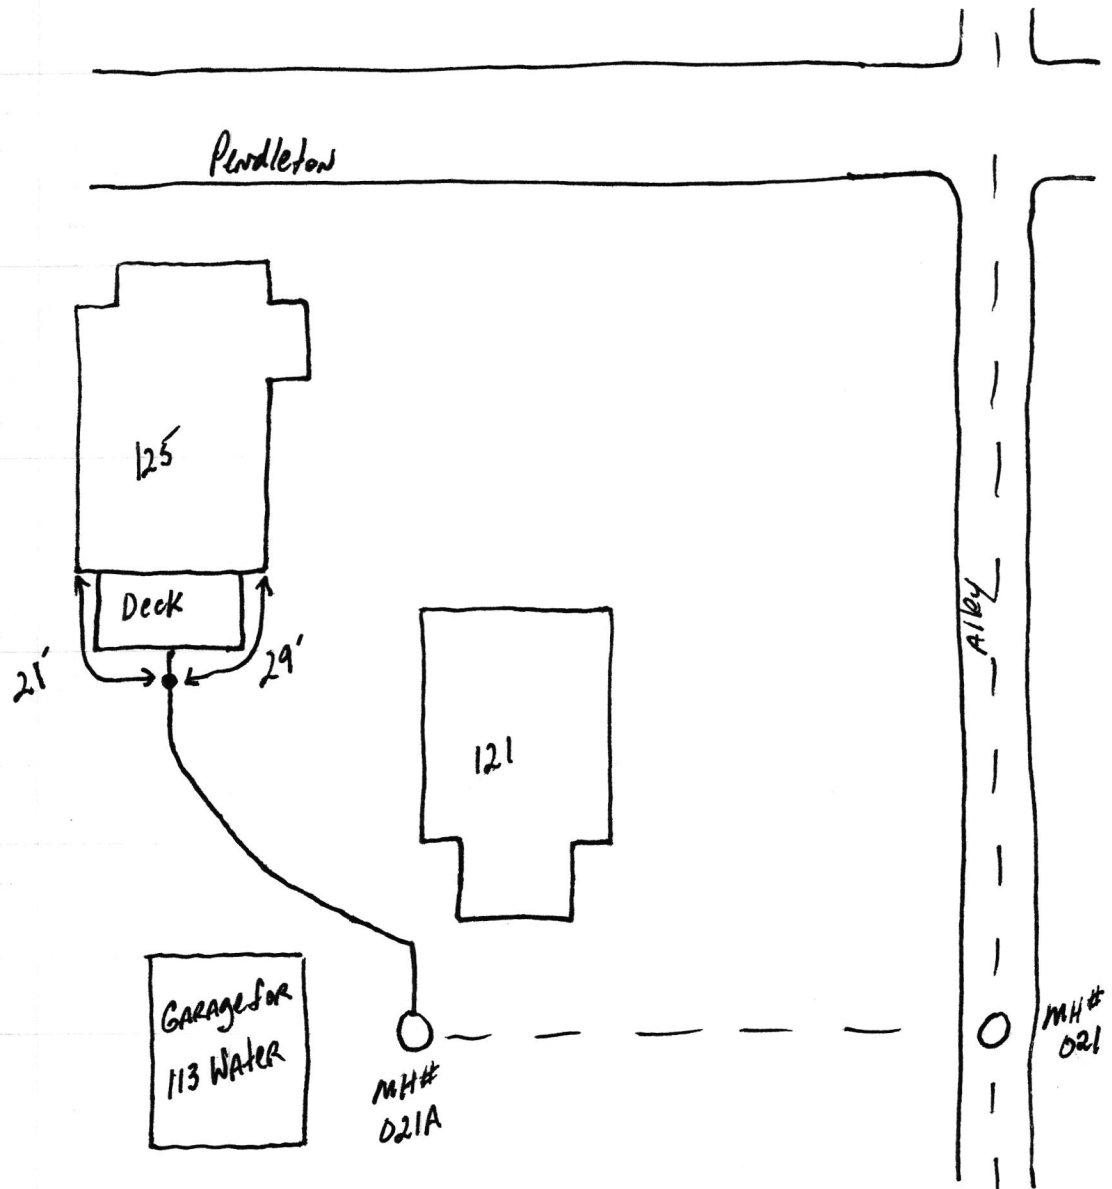



2021-11-15 (Wednesday)

Site Phase II

8.15.18



FALL CREEK REGIONAL WASTE DISTRICT

9378 S. 650 West PO Box 59
Pendleton, IN 46064-0059 778-7544

1-00595.00

APPLICATION FOR SEWER PERMIT

~~No. 2451~~

Date APRIL 28, 1997

Permit Void 90 days from Date of Issuance

Owner Name Gordon Jarrett

Property Address 125 North Pendleton Ave

Lot # _____ P.O. Box _____

Town Pendleton, IN Zip Code 46064

Phone _____ City Water ☒ Well _____

\$ N/A Tap on Fee Paid Lateral Replacement

\$ N/A Inspection fee paid

Application is hereby made for connection to the Fall Creek Regional Waste District Sewer System for the above listed property - Permit Type: Residential ☒, Commercial _____, Industrial _____, or Governmental/Institutional _____. User Information _____.

All workmanship and materials shall conform to the standards of the District Ordinance as described in Ordinance 84-2 and 84-3 as amended. Acceptance and approval must be made by the District inspector or his duly authorized representative before backfilling and final connection is made to the main sewer lines. Any violation of applicable regulations will cause all lines and appurtenances in violation to be removed and replaced at the owners expense.

The Fall Creek Regional Waste District is responsible for the inspection, approval of materials, and installation techniques only. All costs for materials and installation and any liabilities resulting from same is the sole responsibility of the property owner.

I have read and fully understand the above provisions and agree to comply by said provisions.

APPLICANT(S) SIGNATURE

INSPECTOR Tim

Date inspected 4-28-97 Approved ☒ Rejected _____

Reason for rejection _____

Date reinspected _____ Approved _____ Rejected _____

Notes:
Size Pipe 4"
Type Pipe SDR 35
Basement Yes _____ No _____
Sump Pump Yes _____ No _____
Downspout to Ground Yes _____ No _____
Septic Tank Pumped & filled Yes _____ No _____
Contractor GARL DAVIS (TEOS)
Special Conditions Replaced old lateral (full of roots)
Existing Home ☒
New Construction _____

