


GIRL

PROJECT Phase II SHEET _____ OF _____
SUBJECT _____ DATE 4-2-18
JOB NO. 4447
BY Atlas

125 S. Adams

Adams

Tim-Replace
original with
this one

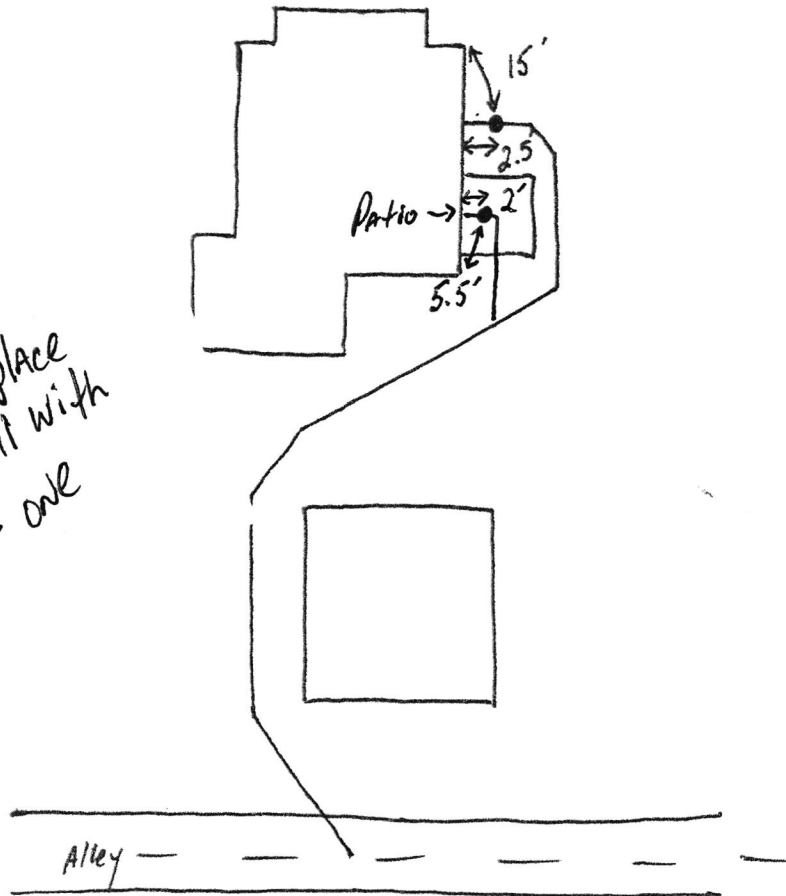

las Adams

SRF Phase II

5.14.18



125 S Adams

SRP Phase II



Gidw.

PROJECT Phase II SHEET _____ OF _____

SUBJECT _____ DATE 4-2-18

JOB NO 4447

BY Atlas

125 S. Adams

Adams

