



met by 7-16-86

FALL CREEK REGIONAL WASTE DISTRICT

Box 44, Pendleton, Indiana 46064

trailer

1-0000 828.00

No 001575

APPLICATION FOR SEWER PERMIT

Permit No. _____ Date 7-9-86
Permit Void 90 days from Date of Issuance
Owner Name Artie Lewis (7332 Sioux Run
INDIANAPOLIS 46219)
Property Address 124 N MANifold
Lot # _____ P.O. Box _____
Town Ingalls, IN Zip Code 46048
Phone 359-5569 Water Meter will be on water
\$ 500.00 Tap on Fee Paid
\$ 25.00 Inspection fee paid

Application is hereby made for connection to the Fall Creek Regional Waste District Sewer System for the above listed property - Permit Type: Residential ☒, Commercial _____, Industrial _____, or Governmental/Institutional _____. User Information _____.

All workmanship and materials shall conform to the standards of the District Ordinance as described in Ordinance 84-2 and 84-3 as amended. Acceptance and approval must be made by the District inspector or his duly authorized representative before backfilling and final connection is made to the main sewer lines. Any violation of applicable regulations will cause all lines and appurtenances in violation to be removed and replaced at the owners expense.

The Fall Creek Regional Waste District is responsible for the inspection, approval of materials, and installation techniques only. All costs for materials and installation and any liabilities resulting from same is the sole responsibility of the property owner.

I have read and fully understand the above provisions and agree to comply by said provisions.


✓ Artie Lewis
APPLICANT(S) SIGNATURE


INSPECTOR BP

Date inspected 3 Approved ☒ Rejected _____
Reason for rejection _____

Date reinspected _____ Approved _____ Rejected _____

Notes:
Size Pipe 6
Type Pipe PVC
Basement Yes _____ No ☒
Sump Pump Yes _____ No ☒
Downspout to Ground Yes ☒ No _____
Septic Tank Pumped & filled Yes _____ No ☒
Contractor HARRY COZART
Special Conditions
NEW TRAILOR NO TANK

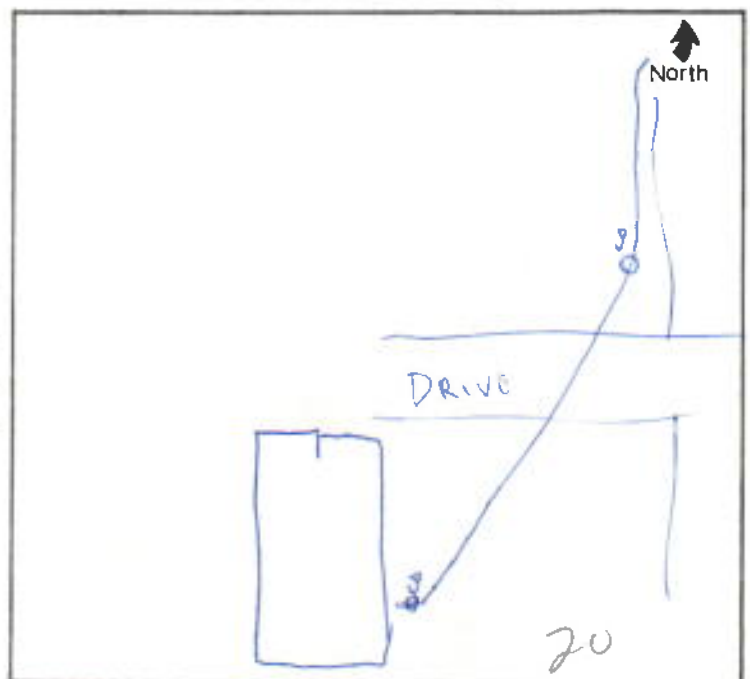

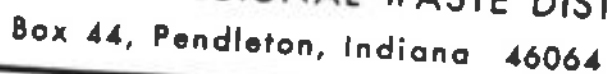

APPLICATION FOR SEWER PERMIT

№ 001575

Permit No.

Date _____

Permit Void 90 days from Date of Issuance

Owner Name

Property Address

Lot #

P.O. Box

Town

Phone

IN Zip Code

\$ 500.00 Tap on Fee Paid

\$ 25.00 Inspection fee paid

Application is hereby made for connection to the Fall Creek Regional
Waste District Sewer System for the above listed property - Permit Type:
Residential ✓, Commercial , Industrial , or Governmental/
Institutional . User Information

All workmanship and materials shall conform to the standards of the District Ordinance as described in Ordinance 84-2 and 84-3 as amended. Acceptance and approval must be made by the District inspector or his duly authorized representative before backfilling and final connection is made to the main sewer lines. Any violation of applicable regulations will cause all lines and appurtenances in violation to be removed and replaced at the owners expense.

The Fall Creek Regional Waste District is responsible for the inspection, approval of materials, and installation techniques only. All costs for materials and installation and any liabilities resulting from same is the sole responsibility of the property owner.

I have read and fully understand the above provisions and agree to comply by said provisions.

APPLICANT(S) SIGNATURE

INSPECTOR

Date inspected 7-17-86

Approved

Rejected

Reason for rejection

Date reinspected

Approved

Rejected

Notes:

Size Pipe

Type Pipe

Basement Yes

No X

Sump Pump

Yes

No X

Downspout to Ground Yes ☒ No

Yes ☒ No

Septic Tank Pumped & filled Yes No ☒

& filled Yes No ☒

Contractor

HARRY DICK

Special Conditions

Empty Lot

No TANK

