

FALL CREEK REGIONAL WASTE DISTRICT

9378 S 650 WEST, P.O. BOX 59, PENDLETON, IN 46064

765-778-7544

No 5301

22-21544.00

AGREEMENT FOR SANITARY SEWER SERVICE

This Agreement made and entered into this 23rd day of July, 2004, between FALL CREEK REGIONAL WASTE DISTRICT ("District") and David Bowden ("Applicant") regarding the provision of sanitary sewer service, and the assignment of capacity in, and connection to, the District's facilities for the premises located at Lantern Meadows lot 15 & part lot 16
126 W Woodland Drive

NOW THEREFORE, the parties, in consideration of the mutual promises set out in this Agreement, the receipt and sufficiency of which is hereby acknowledged, agree as follows:

1. The Applicant agrees that all workmanship and materials shall conform to all District ordinances and the District's construction standards. District must accept and approve all work and materials before backfilling and final connection is made to the sewer main. Any violation of this provision will cause all lines and appurtenances in violation to be removed and replaced at the Applicant's expense.

2. The District shall have the right to enter upon the Applicant's premises at all reasonable times to inspect, repair, or replace any equipment used in connection with the District's service or which has an impact on said service. add in April

3. The Applicant shall be responsible for all capacity charges, and tap fees. The failure to pay any rate charge or fee may result in a suspension of the property and/or the termination of service to the property, the cost of which will be borne by Applicant, including, but not limited to, all attorney's fees and collection costs.

4. The District shall not be responsible for any damages as a result of any failure to supply service unless said damages are due to default, neglect or culpability on the part of the District.

5. If there is an available sanitary sewer within three hundred (300) feet of the property line, the property owner shall be required to connect to the District's sanitary sewer system.

6. The Applicant and District agree that the provision of sanitary sewer service touches and concerns the property and the terms of this Agreement bind the District and Applicant and their heirs, executors, administrators, personal representatives, successors, agents, attorneys, assigns, designees, and transferees.

The parties hereto have read and fully understand the above provisions and agree to comply with said provisions.

FALL CREEK REGIONAL WASTE DISTRICT
Deborah Wilson
Signature

APPLICANT
David Bowden
Signature

STATE OF INDIANA)
) SS:
COUNTY OF MADISON)

SUBSCRIBED and sworn to before me this 23rd day of July, 2004.

My Commission Expires:
2-20-2008

Signature Deborah L. Wilson
Printed Deborah L. Wilson

Notary Public
Resident of Madison County

INSPECTOR TK DATE INSPECTED 8/17/04 APPROVED ✓ REJECTED _____

REASON FOR REJECTION _____

DATE REINSPECTED _____ APPROVED _____ REJECTED _____

NOTES:
SIZE PIPE 6" TYPE PIPE SDR35

BASEMENT YES NO

SUMP PUMP YES NO

DOWNSPOUT TO GROUND YES NO


SEPTIC TANK PUMPED & FILLED YES NO

CONTRACTOR BALDWIN

SPECIAL CONDITIONS _____

EXISTING HOME _____

NEW CONSTRUCTION X

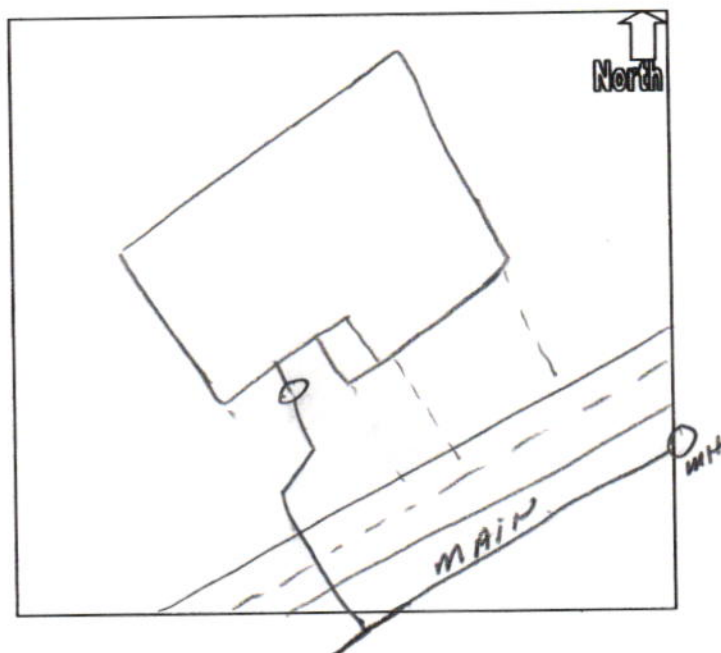

DAVID J. BOWDEN 09/01
JESSICA M. BOWDEN
3316 N PAULINE AVE. PH. 765-760-1412
MUNCIE, IN 47304

1452

71-1/863

Date 7/23/04

Pay to the
Order of

FC RWD

\$ 2,435

TWO-THOUSAND-SIX-HUNDRED-AND-THIRTY-FIVE Dollars

Security features
are included.
Details on back.



OLD NATIONAL BANK
Muncie, Indiana • www.oldnational.com

Bank of Work

For

SEWER TAP/CONNECTION FEE

WAB

MP

⑆086300012⑆

01452