

Gidw.

PROJECT Phase II SHEET _____ OF _____


SUBJECT _____ DATE 5-31-18

JOB NO. 4447

BY AH/AS

127 Spring

N →

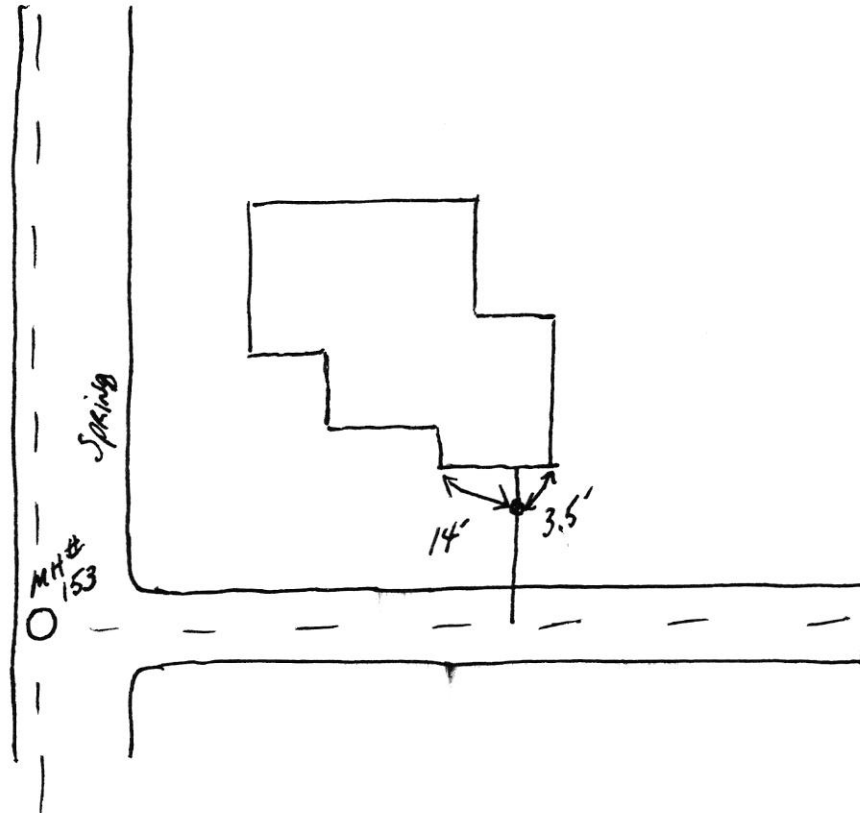

127 Spring

SRF Phase II

6-2-18

