



FALL CREEK REGIONAL WASTE DISTRICT

Box 44, Pendleton, Indiana 46064

10-23307.00

3.1023307.00

APPLICATION FOR SEWER PERMIT

Permit No. 7 Date December 27, 1984

Permit Void 90 days from Date of Issuance

Owner Name Wanda Crumley 127 W Central

Property Address 3rd Ave West side behind Bous

Lot # \_\_\_\_\_ P.O. Box R 3, Box 152

Town Pendleton, IN Zip Code 46064

Phone 778-3214 Water Meter 5/8

\$ 150.00 Tap on Fee Paid

\$ 25.00 Inspection fee paid

Application is hereby made for connection to the Fall Creek Regional Waste District Sewer System for the above listed property - Permit Type: Residential ☒, Commercial \_\_\_\_\_, Industrial \_\_\_\_\_, or Governmental/Institutional \_\_\_\_\_. User Information \_\_\_\_\_.

All workmanship and materials shall conform to the standards of the District Ordinance as described in Ordinance 84-2 and 84-3 as amended. Acceptance and approval must be made by the District inspector or his duly authorized representative before backfilling and final connection is made to the main sewer lines. Any violation of applicable regulations will cause all lines and appurtenances in violation to be removed and replaced at the owners expense.

The Fall Creek Regional Waste District is responsible for the inspection, approval of materials, and installation techniques only. All costs for materials and installation and any liabilities resulting from same is the sole responsibility of the property owner.

I have read and fully understand the above provisions and agree to comply by said provisions.

X Wanda M. Crumley  
APPLICANT(S) SIGNATURE

INSPECTOR [Signature]

Date inspected 11-29-84 Approved ☒ Rejected \_\_\_\_\_

Reason for rejection \_\_\_\_\_

Date reinspected \_\_\_\_\_ Approved \_\_\_\_\_ Rejected \_\_\_\_\_

Notes:

Size Pipe 6 "

Type Pipe PVC D-3034

Basement Yes \_\_\_\_\_ No ☒

Sump Pump Yes \_\_\_\_\_ No ☒


Downspout to Ground Yes \_\_\_\_\_ No ☒

Septic Tank Pumped & filled Yes \_\_\_\_\_ No ☒

Contractor Tony Russell

Special Conditions \_\_\_\_\_

↑  
NORTH

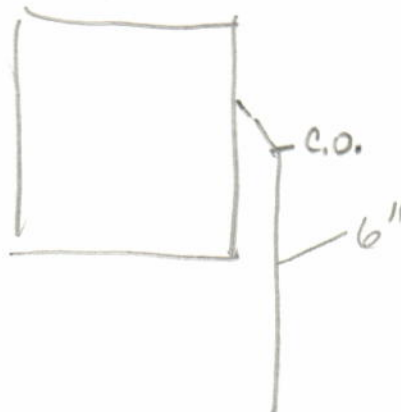

60