

G.R.W.


PROJECT Phase II SHEET _____ OF _____

SUBJECT _____ DATE _____

JOB NO. 4447

BY Atlas

128 S. MAIN

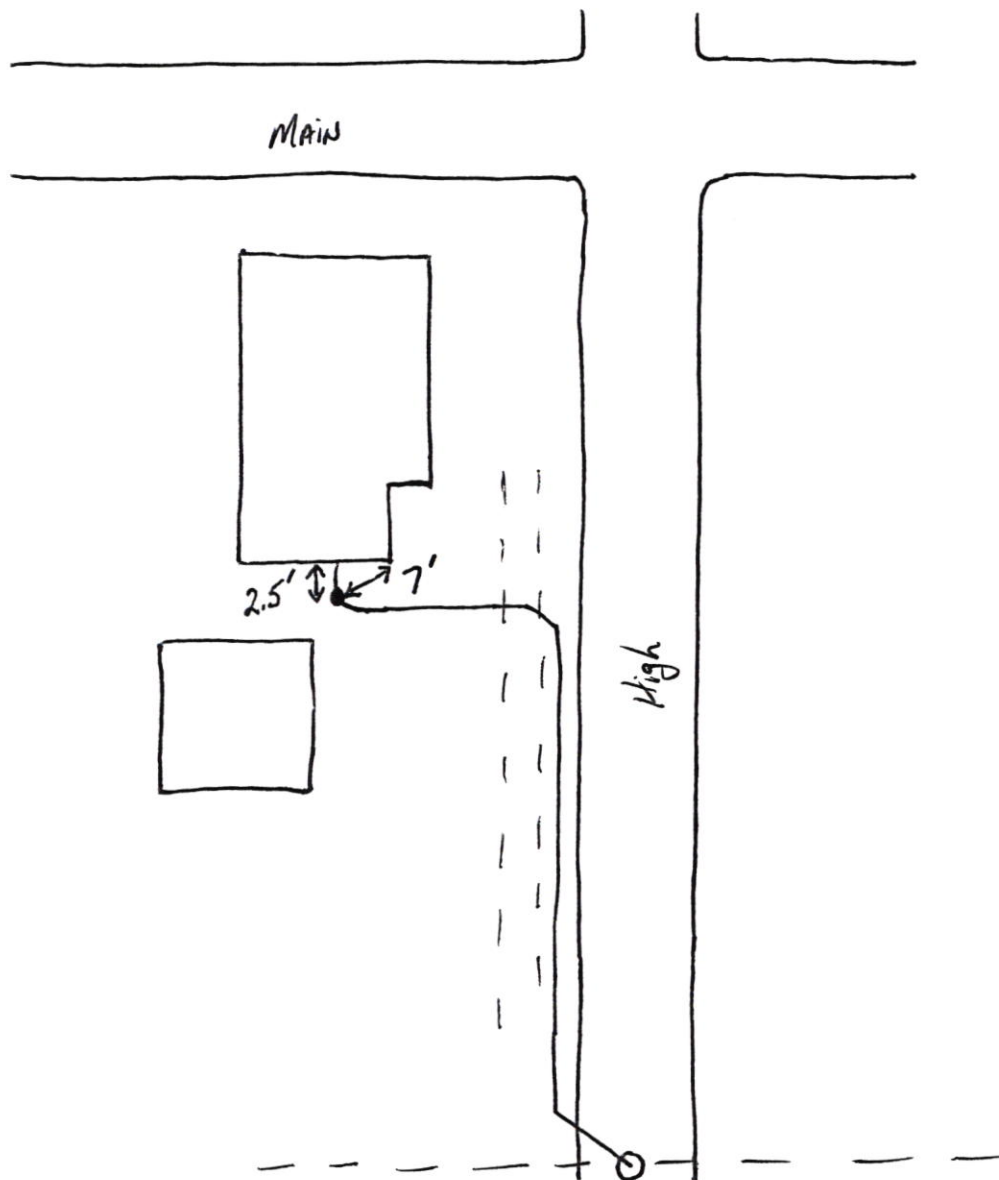

128 S main

SRP
Phase II

4.20.18

