

Gidw.

PROJECT Phase II SHEET _____ OF _____


SUBJECT _____ DATE 7-19-18

JOB NO. 4447

BY Atlas

129 S. BROADWAY

N →

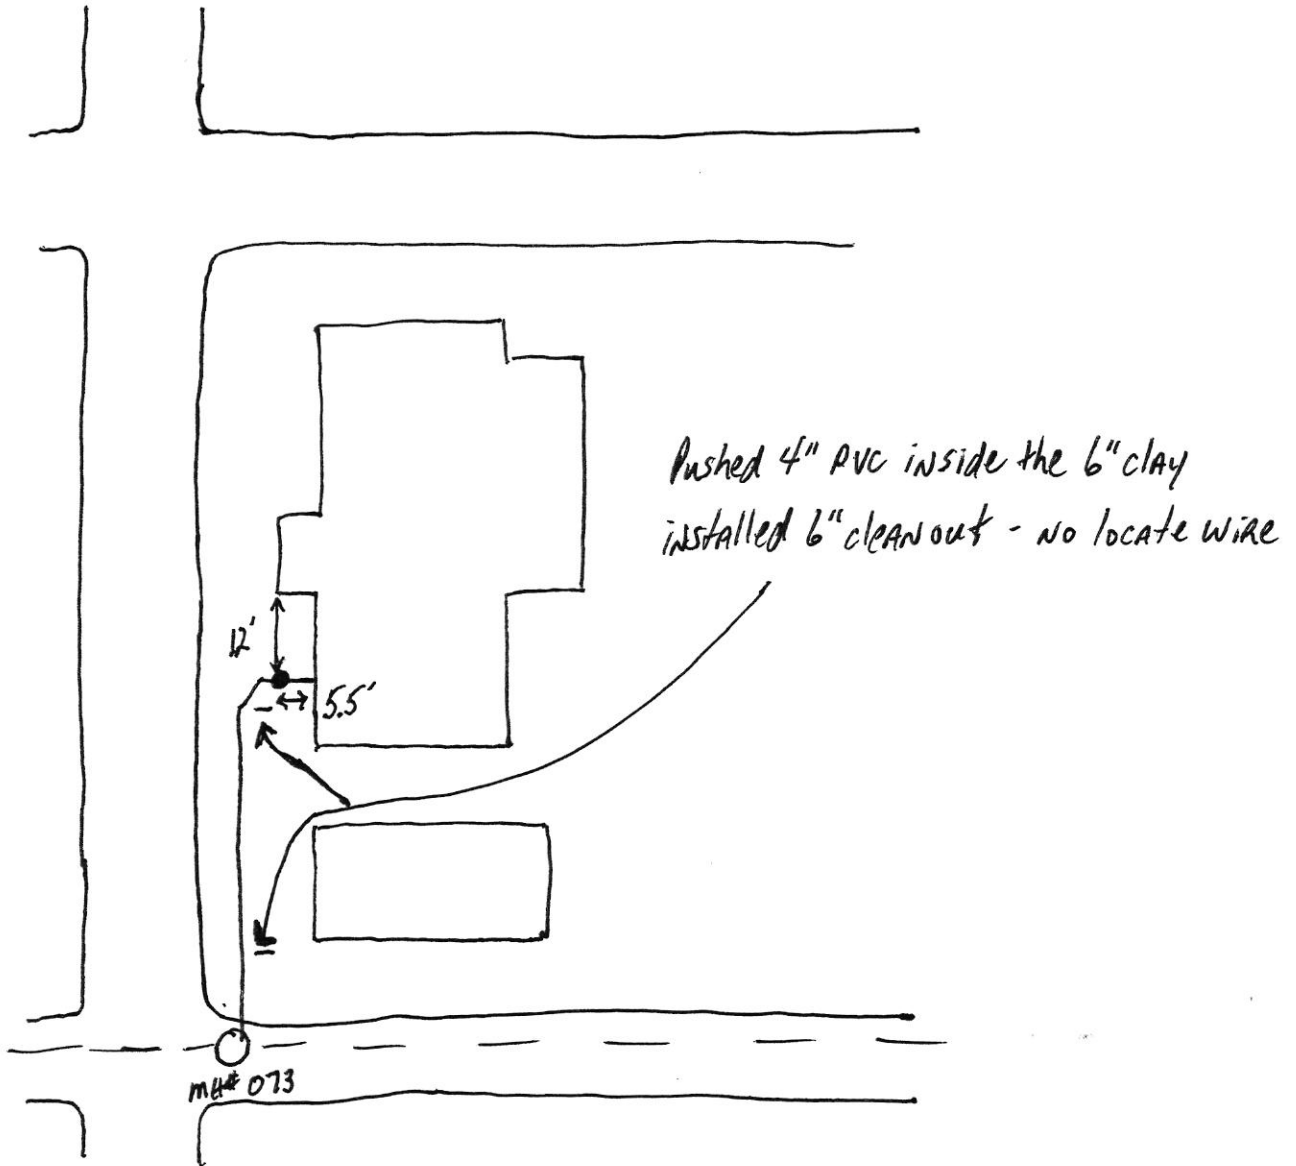

129 S Broadway

SPE Phase II

7.30.18

