

add order  
on file



# FALL CREEK REGIONAL WASTE DISTRICT

9378 S. 650 West PO Box 59  
Pendleton, IN 46064-0059 778-7544

10-23690.00

## APPLICATION FOR SEWER PERMIT

Nº 2440

Date 12-13-96

Permit Void 90 days from Date of Issuance

Owner Name Creel

Property Address 130 E Central Way

Lot # 47 P.O. Box \_\_\_\_\_

Town Pendleton, IN Zip Code 46064

Phone \_\_\_\_\_ City Water ☒ Well \_\_\_\_\_

\$ 400.00 Tap on Fee Paid  
\$ 1900.00 Capacity fee paid

Application is hereby made for connection to the Fall Creek Regional Waste District Sewer System for the above listed property - Permit Type: Residential ☒, Commercial \_\_\_\_\_, Industrial \_\_\_\_\_, or Governmental/Institutional \_\_\_\_\_. User Information \_\_\_\_\_.

All workmanship and materials shall conform to the standards of the District Ordinance as described in Ordinance 84-2 and 84-3 as amended. Acceptance and approval must be made by the District inspector or his duly authorized representative before backfilling and final connection is made to the main sewer lines. Any violation of applicable regulations will cause all lines and appurtenances in violation to be removed and replaced at the owners expense.

The Fall Creek Regional Waste District is responsible for the inspection, approval of materials, and installation techniques only. All costs for materials and installation and any liabilities resulting from same is the sole responsibility of the property owner.

I have read and fully understand the above provisions and agree to comply by said provisions.

[Signature]  
APPLICANT(S) SIGNATURE

\*\*\*\*\*

INSPECTOR Tina

Date inspected 12/16/96 Approved ☒ Rejected \_\_\_\_\_

Reason for rejection \_\_\_\_\_

Date reinspected \_\_\_\_\_ Approved \_\_\_\_\_ Rejected \_\_\_\_\_

### Notes:

Size Pipe 6"

Type Pipe SDR 35

Basement Yes \_\_\_\_\_ No ☒

Sump Pump Yes \_\_\_\_\_ No ☒

Downspout to Ground Yes ☒ No \_\_\_\_\_

Septic Tank Pumped & filled Yes \_\_\_\_\_ No \_\_\_\_\_

Contractor Brian Brown MADE TAP


Special Conditions G&R Construction

Brown Line Stone About 2'

Existing Home \_\_\_\_\_

New Construction ☒

Tap installed 11/27/96

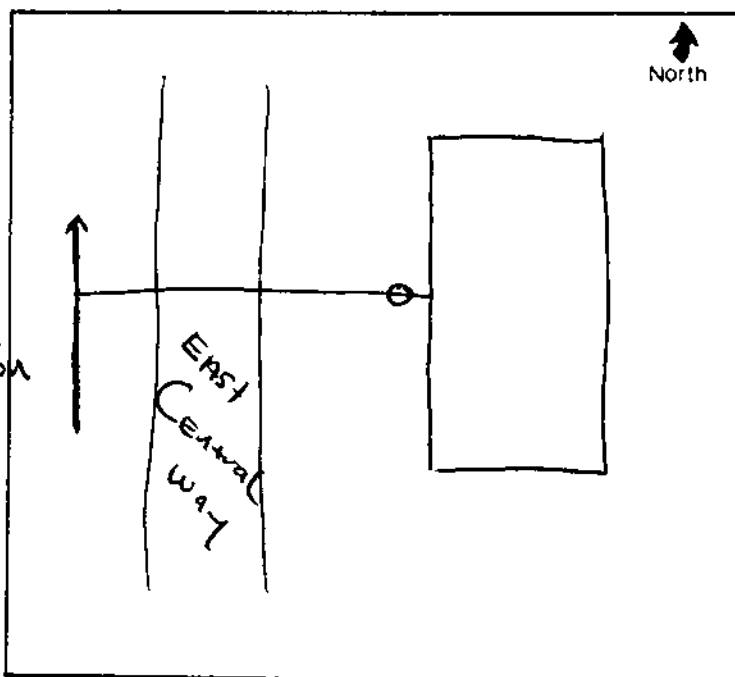

# Heritage Homes

of Anderson Inc.

Phone (317) 778-8139 Fax (317) 778-8139

## Job Information

Print Date: 10/23/96

**Job Number:** 96610 **Last name:** Creel

**Address 1**

130 E. Central Way

Pendleton

IN 46064

**Home phone:** (317) 778-4717

**Work phone**

**Field Manager** None assigned

**Pager**

**Directions to job**

South on 67 from Anderson, west 2 blocks

on Water St. (furniture mart on corner) in Pendleton, south on East Central Way.

**Plan name:**

**County:** Madison

**Township:** Fall Creek

**Subdivision:**

**Lot #:** 47

## Permit information

**Drive permit #**

**Septic permit #**

**Building permit #**

3181

**Building inspections call:**

**Septic / Sewer inspections:**

## Utility information

**Sewer:**

**Water:**

**Electric:** Pendleton Utilities 778-2173

**Gas:** Indiana Gas 800-666-3096

**For underground utility locations call 1-800-382-5544 (Holey Moley)**

Holey Moley verification #'s

1. \_\_\_\_\_ Date: \_\_\_\_\_

2. \_\_\_\_\_ Date: \_\_\_\_\_

3. \_\_\_\_\_ Date: \_\_\_\_\_

*Need inspect  
ASAP today*